

R-9580

1 OF 2

TOWNSHIP

7S

, RANGE

27E

, SECTION

8

, H.M.

6

5

Application No. R-64043
Permit No. R 9580

1750'

700'
Q

8

7

NAME

Forks Res.

COUNTY


Grant

RECEIVED

AUG 30 1982

WATER RESOURCES DEPT.
SALEM, OREGON

R-9580

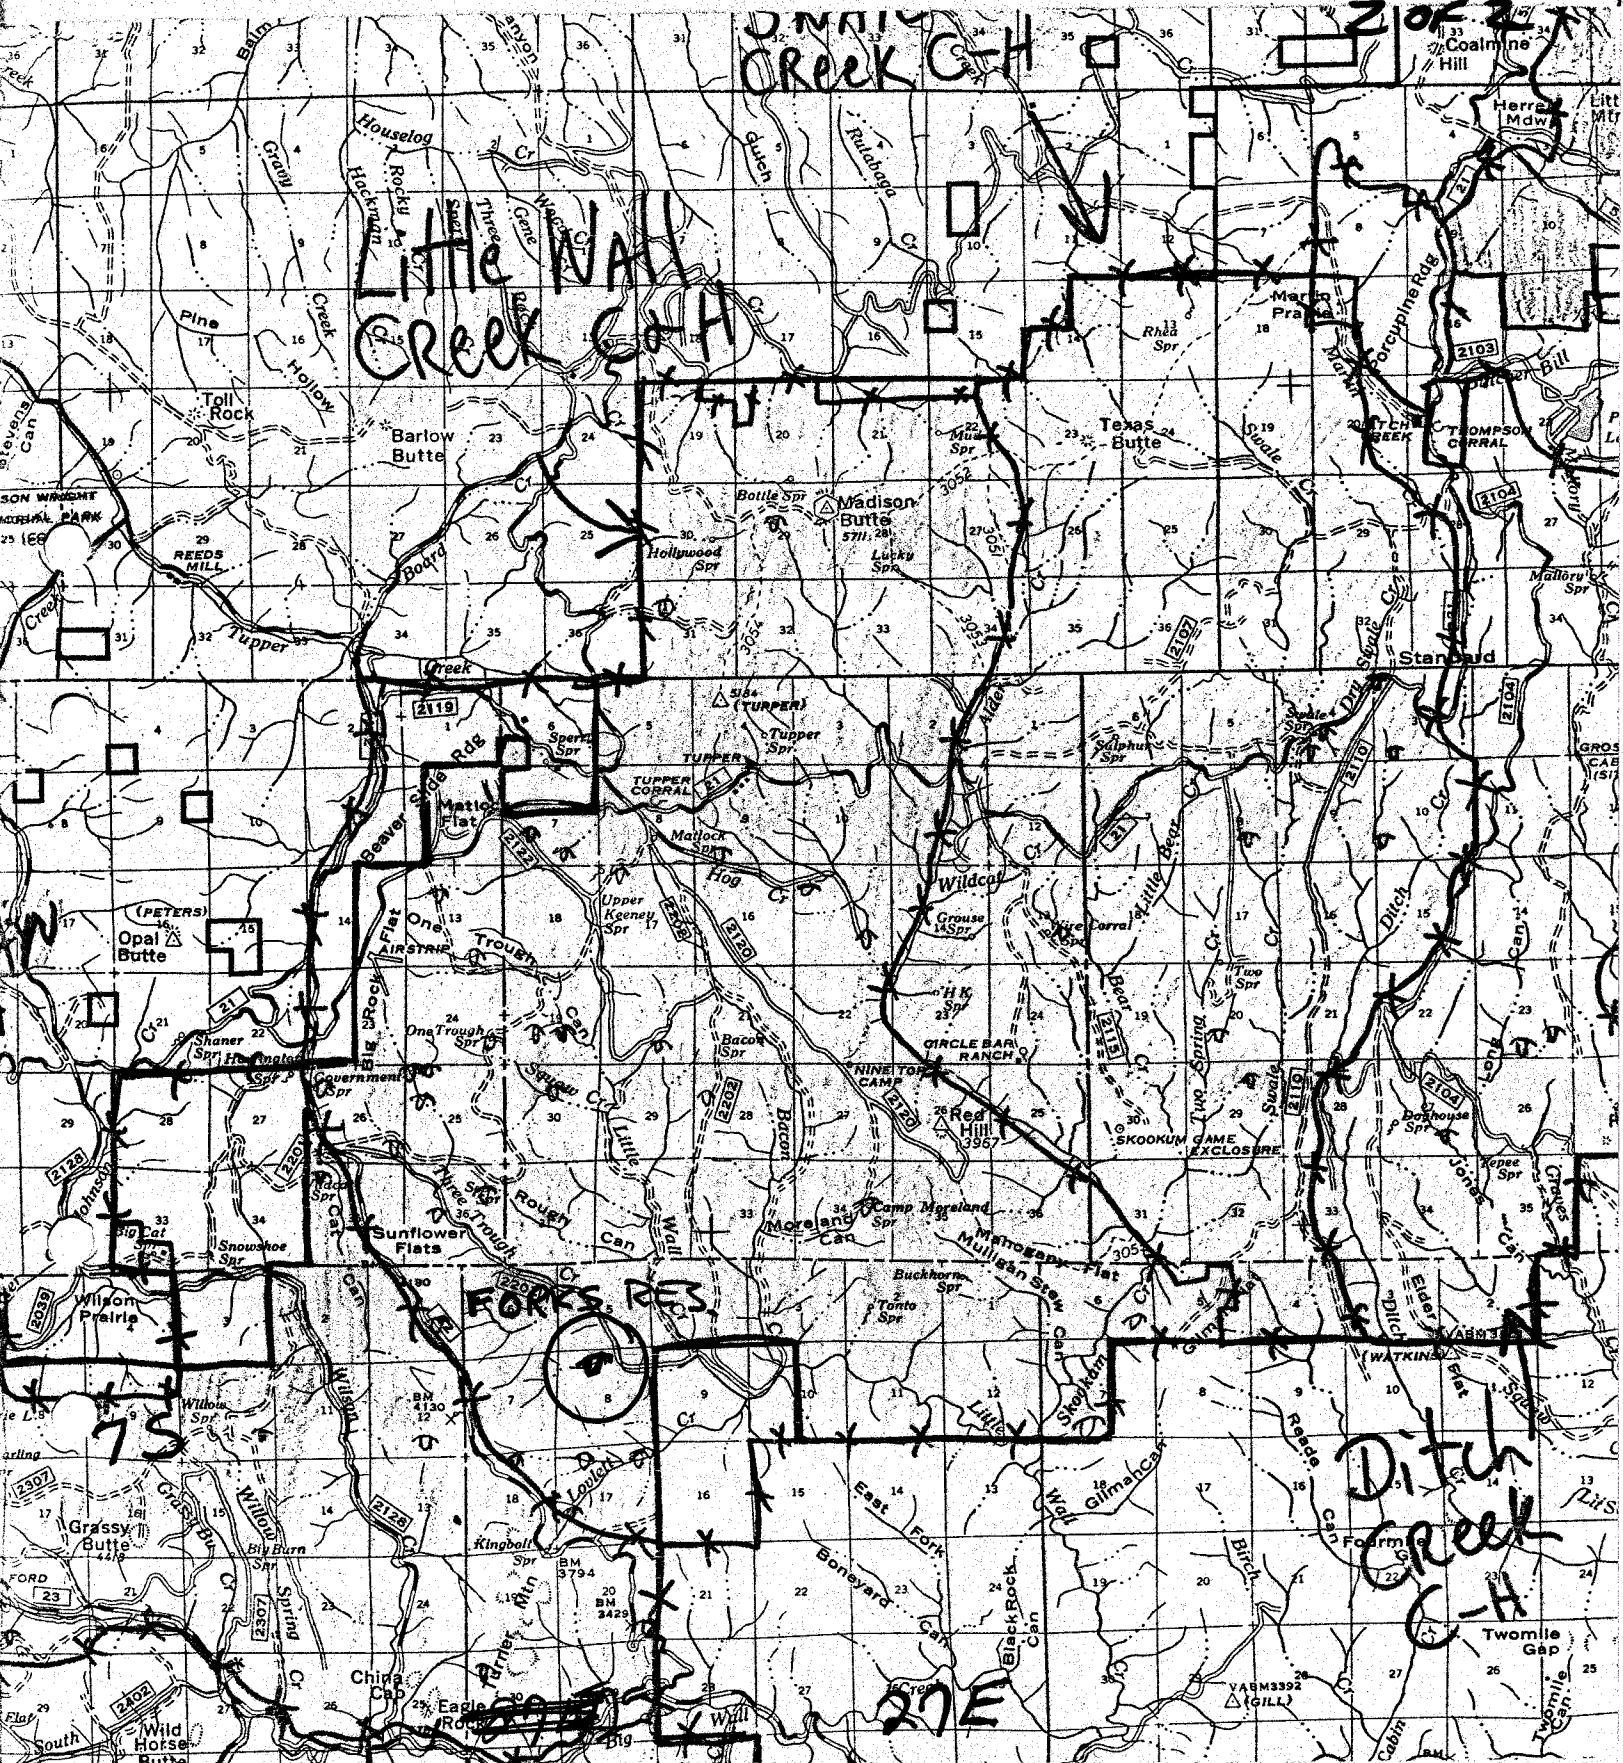

Application No. R-64043
Permit No. R 9580

RECEIVED
AUG 30 1982
WATER RESOURCES DEPT.
SALEM, OREGON