c1371
R-9583
1 OF 2

TOWNSHIP 7 S , RANGE 25 E , SECTION 16 , W.M.

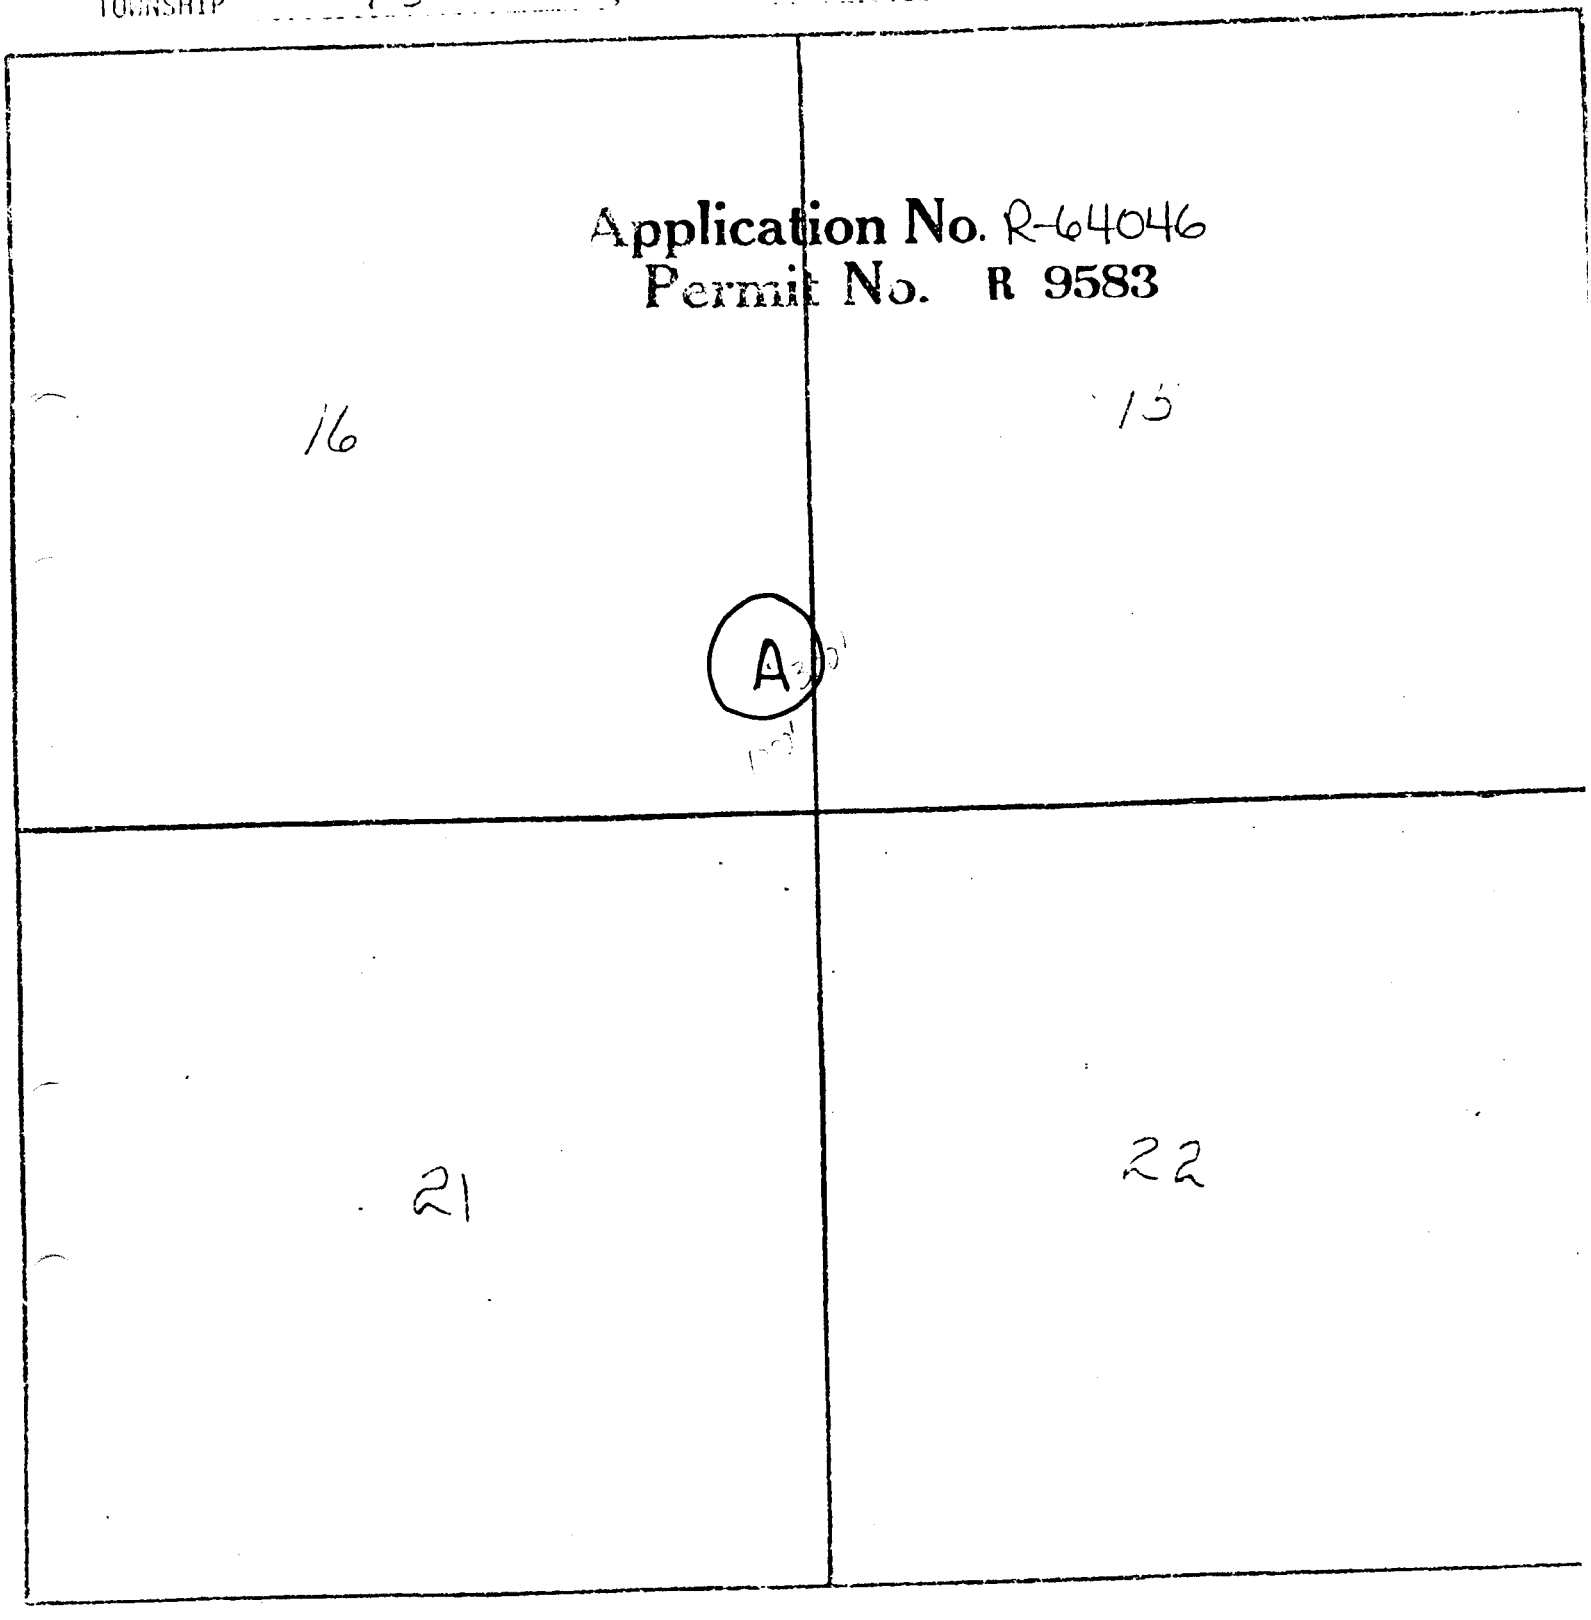

NAME Hillside Res. COUNTY Wheeler

RECEIVED
AUG 30 1982
WATER RESOURCES DEPT.
SALEM, OREGON

R-9583
2 of 2

Application No. R-64046
Permit No. R 9583

25E

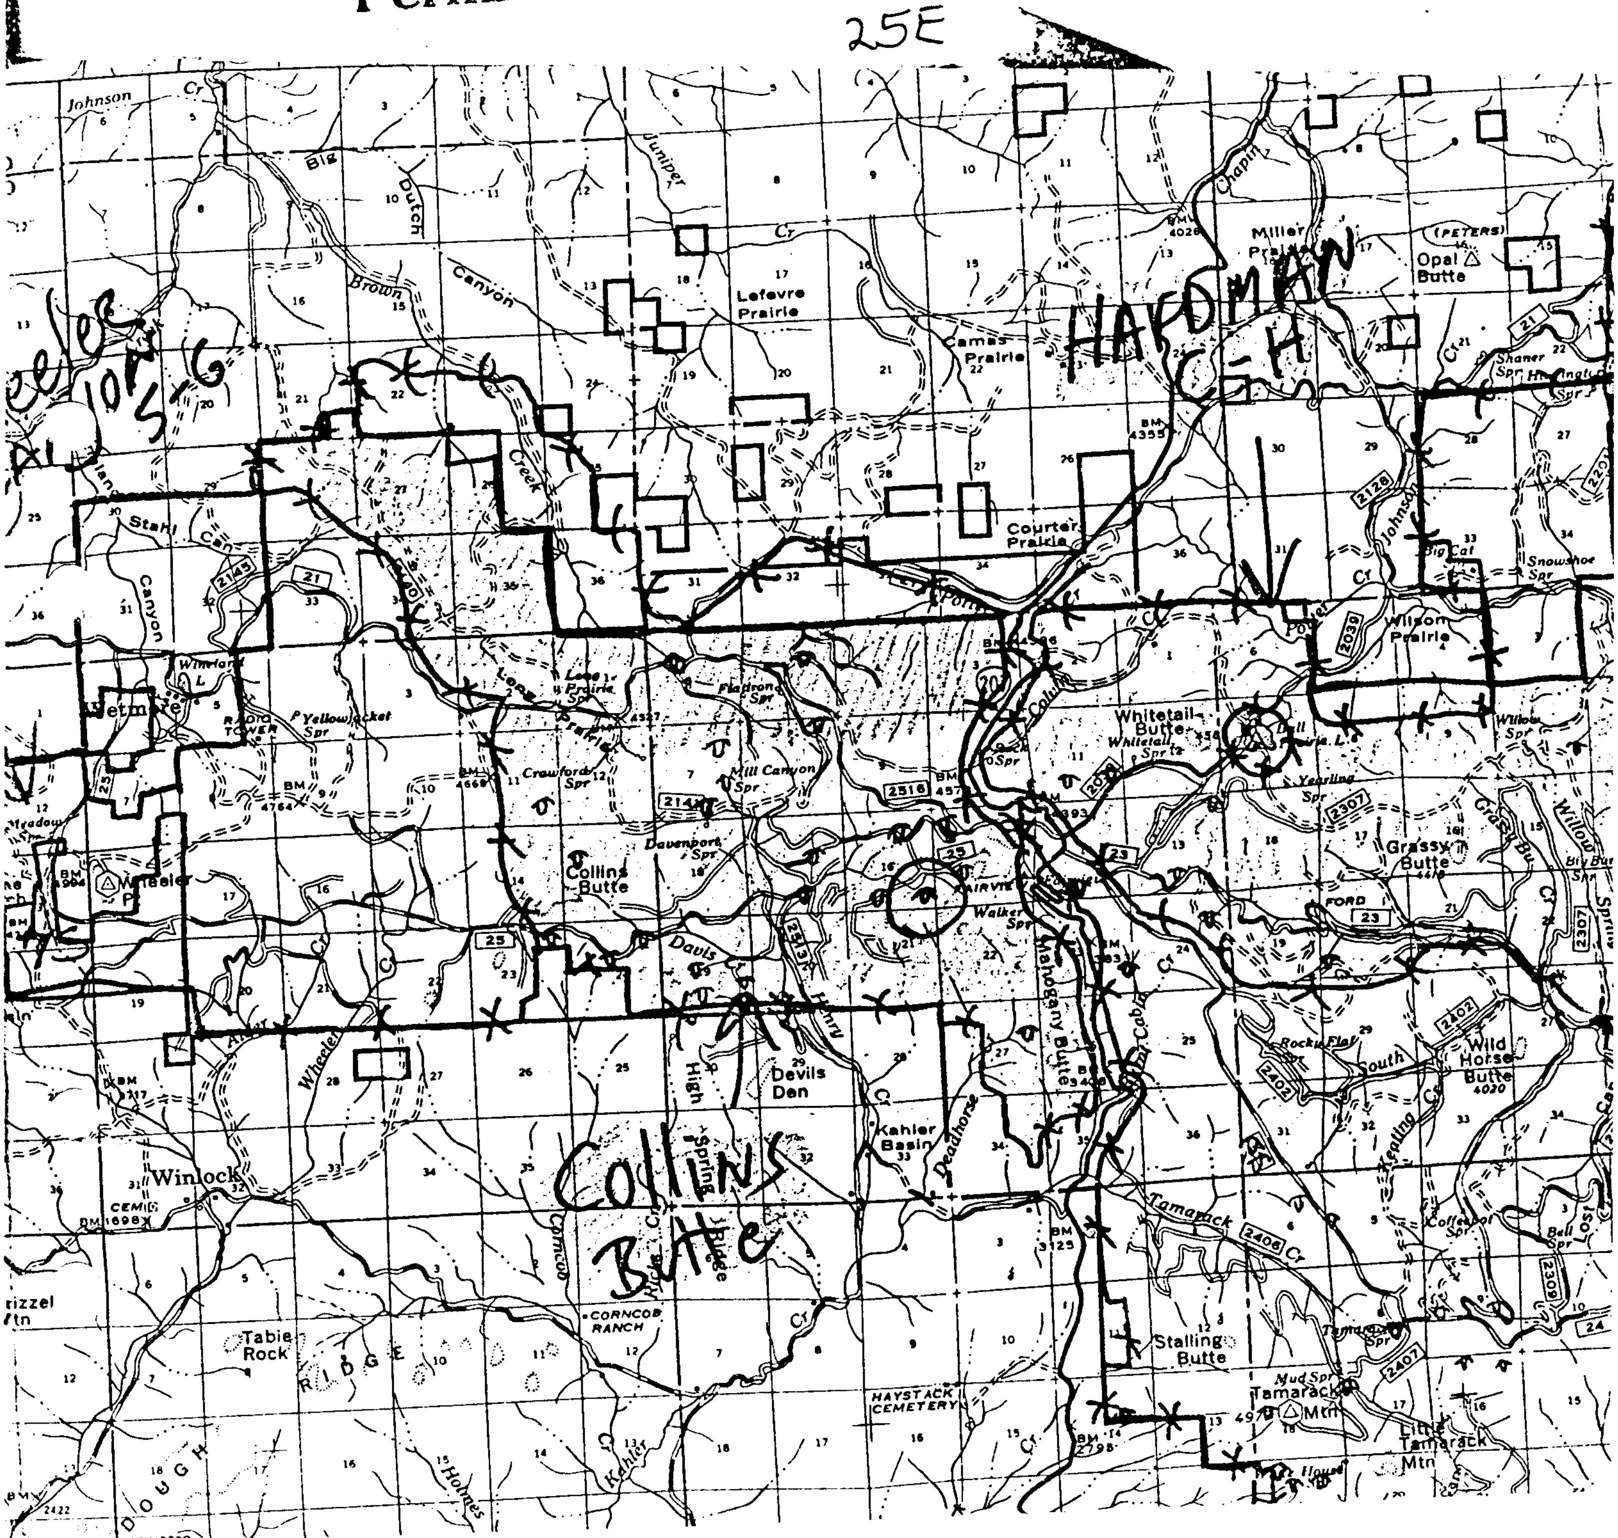

RECEIVED
AUG 30 1982
WATER RESOURCES DEPT.
SALEM, OREGON