


T. 9 S., R. 14 E., W.M.

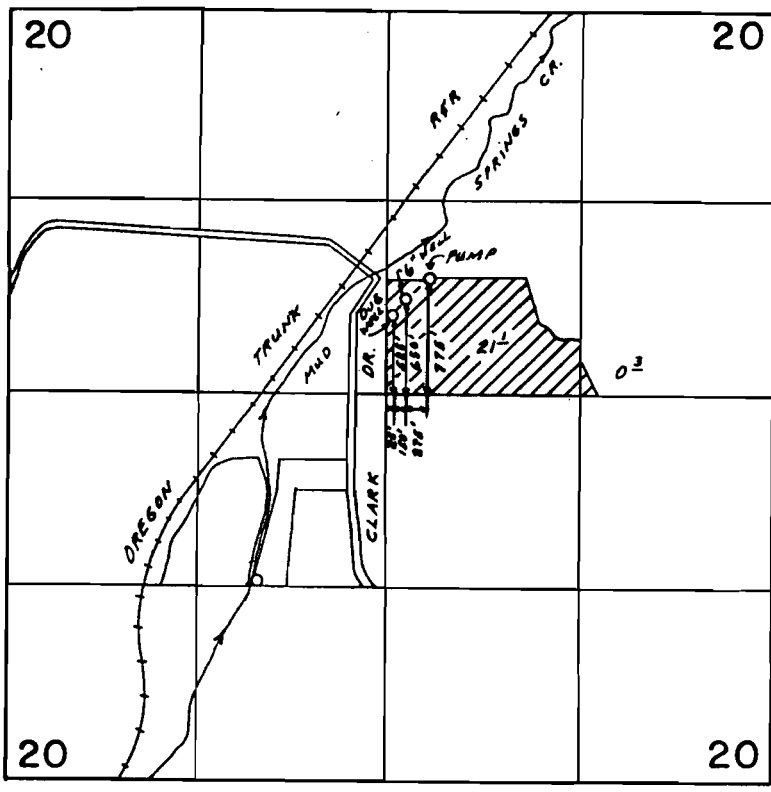

SCALE: 1"=1320'

FINAL PROOF SURVEY UNDER

Application No. G-6261 Permit No. G-5898
IN NAME OF

Cert. # 61373

JOHN O. STUBBE

Surveyed AUG. 9 1988, by B. BISHOP

RECEIVED

DATE 6-7-89

WATER MASTER DISTRICT #11

BY [Signature]