


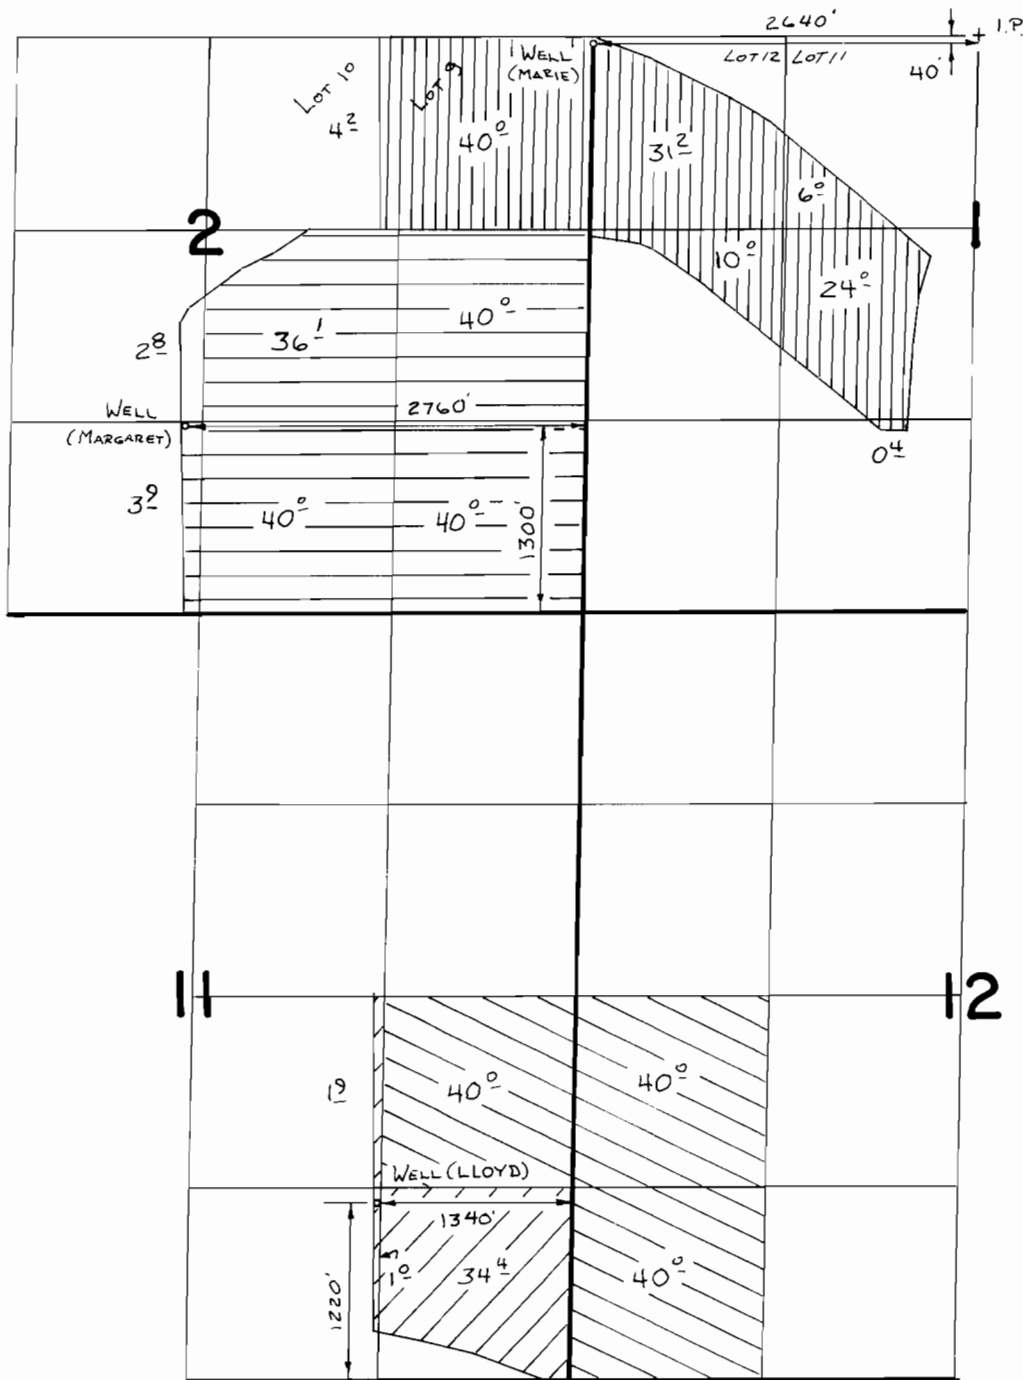

T. 28S.,
R. 29 1/2 E.,
W. M.



Scale 1"=1320'

-  SUPPL G-7836
-  PRI. G-7836
-  PER. G-6595
-  PER. G-8772

FINAL PROOF SURVEY

UNDER

G-9413

G-8772

G-7148

G-6595

Application No. ~~G-8387~~ Permit No. ~~G-7836~~

IN NAME OF

HENRY H. CHURCH

Surveyed 5-7 1988, by J.M. WARREN