


T. 9 S., R. 14 E., W.M.

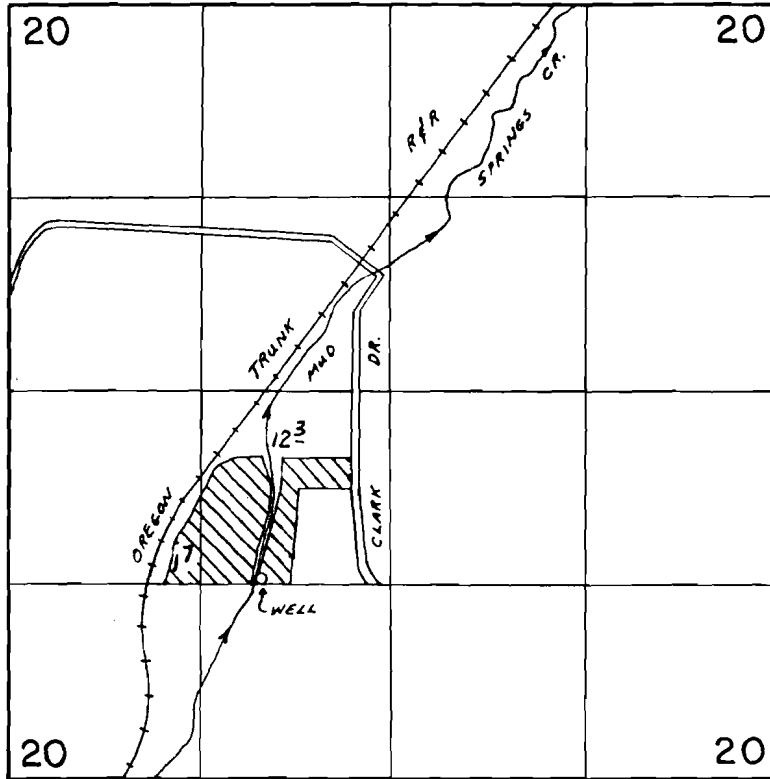

WELL LOC: 1350' N & 1730' E. FROM SW COR. SEC. 20

SCALE: 1"=1320'

FINAL PROOF SURVEY UNDER

Application No. G-8249 Permit No. G-8112
IN NAME OF

Plat. 61379

ROBERT D. SHORT

Surveyed AUG. 9 1988, by B. BISHOP

RECEIVED

DATE 6-7-89

WATER MASTER DISTRICT #11

BY *DM*

12-5-88

41013-179-94A LLC

G-8112