
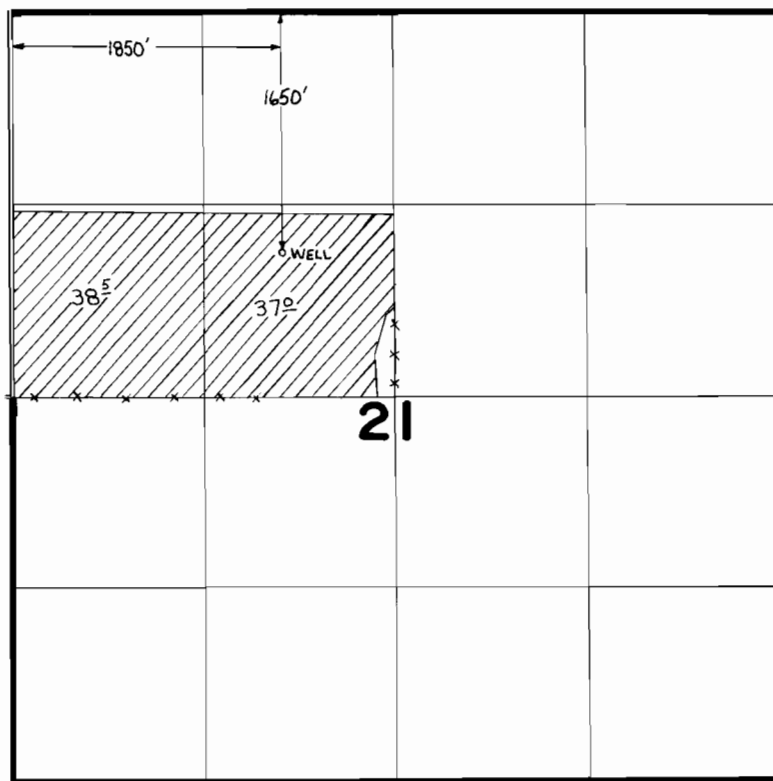


T. 4 S. R. 18 E. W.M.

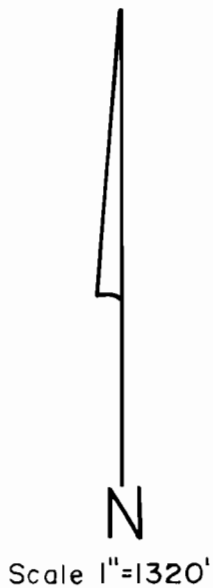

FINAL PROOF SURVEY
UNDER

Application No. G.9594... Permit No. G.9495.....
IN NAME OF

CHARLES E. BOTHWELL

Surveyed May 14, 1986, by V. Church.....