


T.1S.,R.3W.,W.M.

Section 11

SE 1/4 NE 1/4

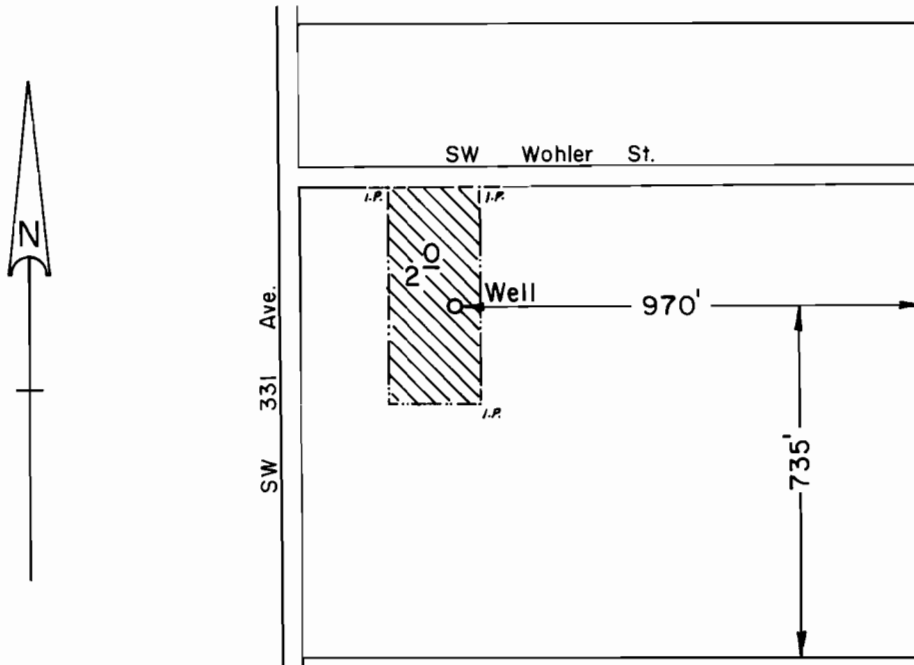

SCALE : 1" = 400'

FINAL PROOF SURVEY UNDER

Application No. G-9751 Permit No. G-9499.....
IN NAME OF

.....GARY L. EVANS.....

Surveyed Nov. 3, 1983, by L. M. TOLL.....