
G-9111

T. 2S., R. 39E., W.M.

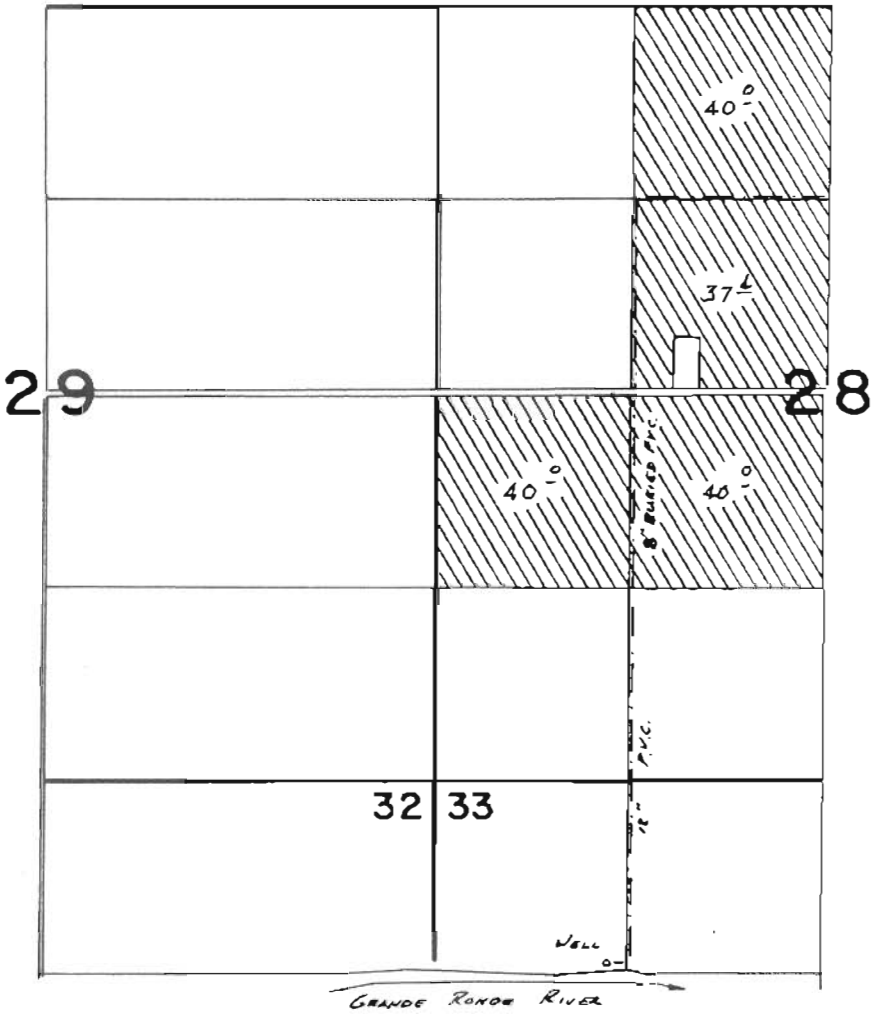

WELL LOCATED 1250'S. & 1190'E FROM NW COR SEC 33

FINAL PROOF SURVEY

UNDER

Application No. G-9974 Permit No. G-9111

IN NAME OF

SHARON HAMANN

Surveyed Aug. 24, 1983, by E.L. Church

2754 8/31/83