


T. 5 S., R. 1 W., W. M.

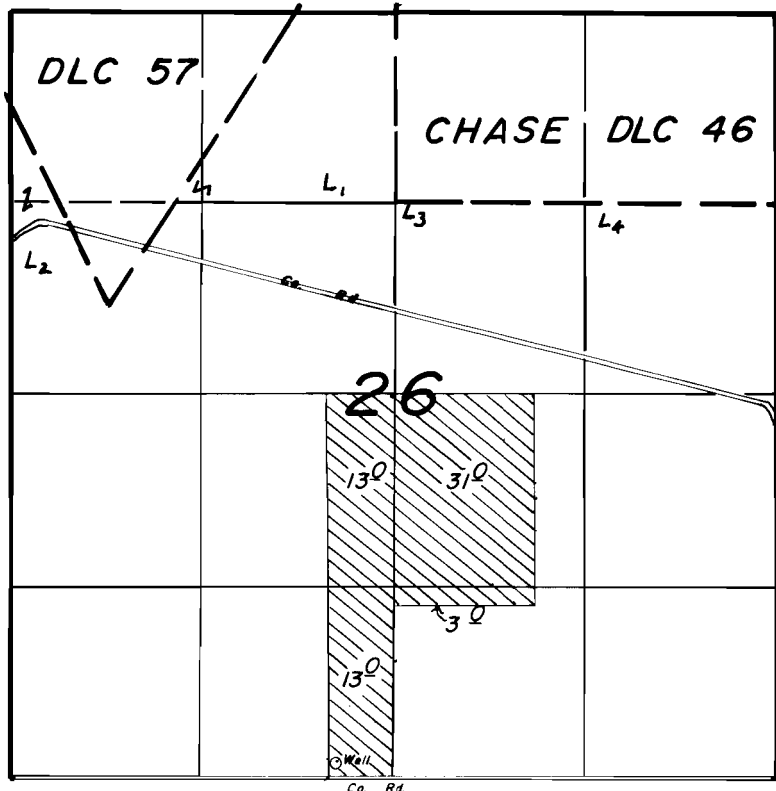

Well Loc.: 100' N. & 400' W. from S. 1/4 Cor. Sec. 26.

1" = 1320'
FINAL PROOF SURVEY
UNDER

Application No. G-10021.. Permit No. G-9181.....
IN NAME OF

JOE. H. HITZ

Surveyed April..20. 19.84., by .T. Warren.....