


T.9S.,R.3W.,W.M.

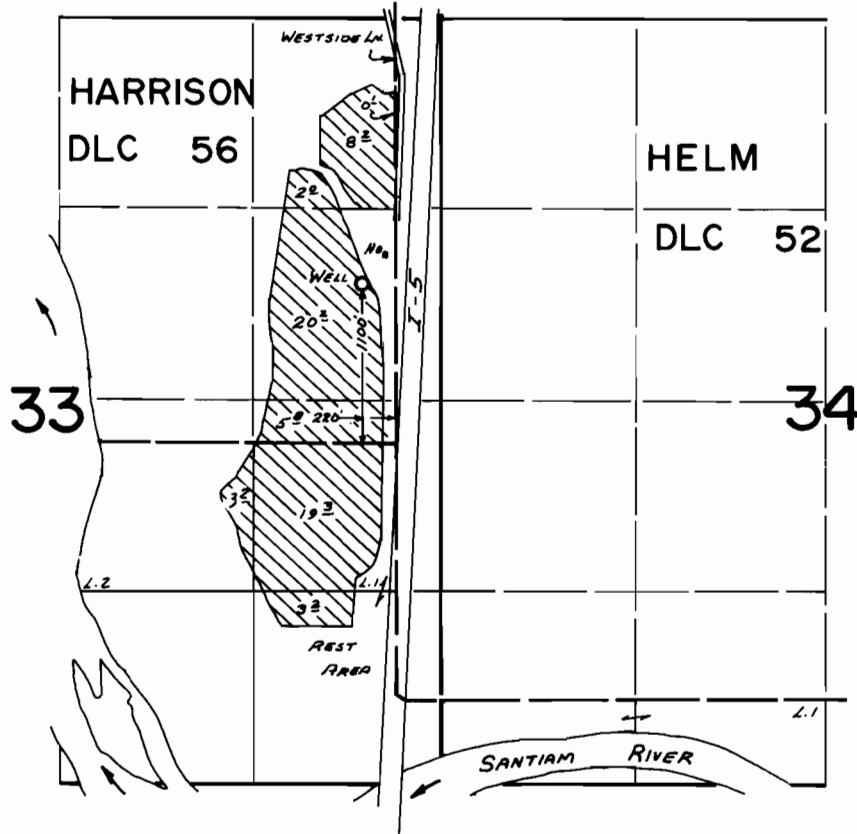

**FINAL PROOF SURVEY**  
UNDER

Application No. G-10070 Permit No. G-9153.....  
IN NAME OF

.....ARTHUR C. WHITE.....

Surveyed Aug. 5, 1981, by L. TOLL.....