


T. 4S., R. 5W., W.M.

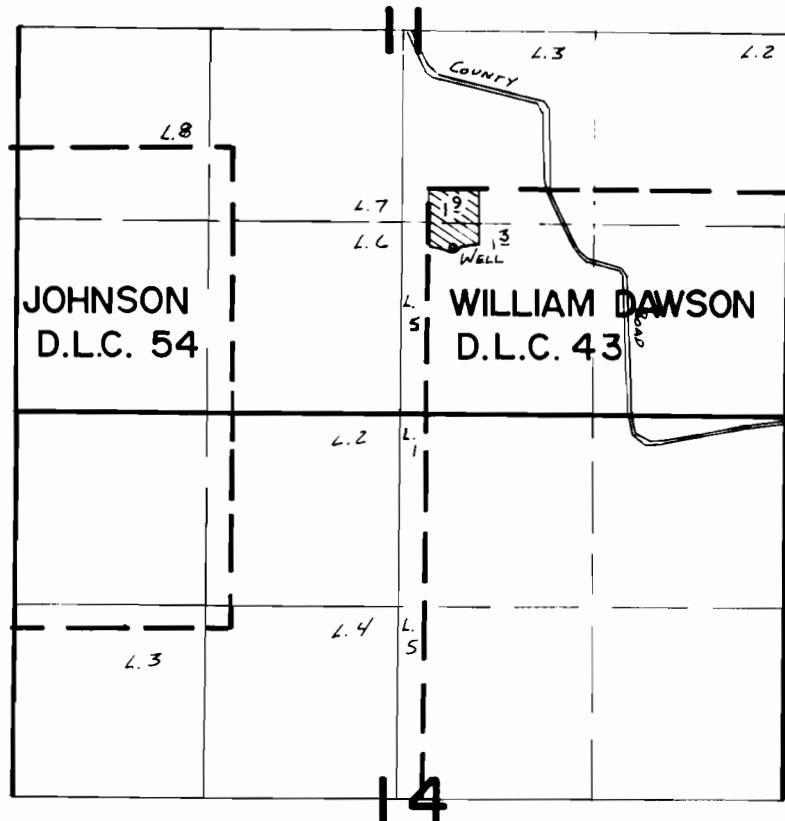

WELL LOCATED 400'S. & 180'E. FROM NW COR. D.L.C. 43

Scale 1" = 1320'

FINAL PROOF SURVEY
UNDER

Application No. G-10111..... Permit No. G-9182.....
IN NAME OF

.....BUERNELL.....L.....SEIBEL.....

Surveyed 7-23..... 1984, by P. Pagter.....