


# T. 2 N. R. 32 E. W.M.

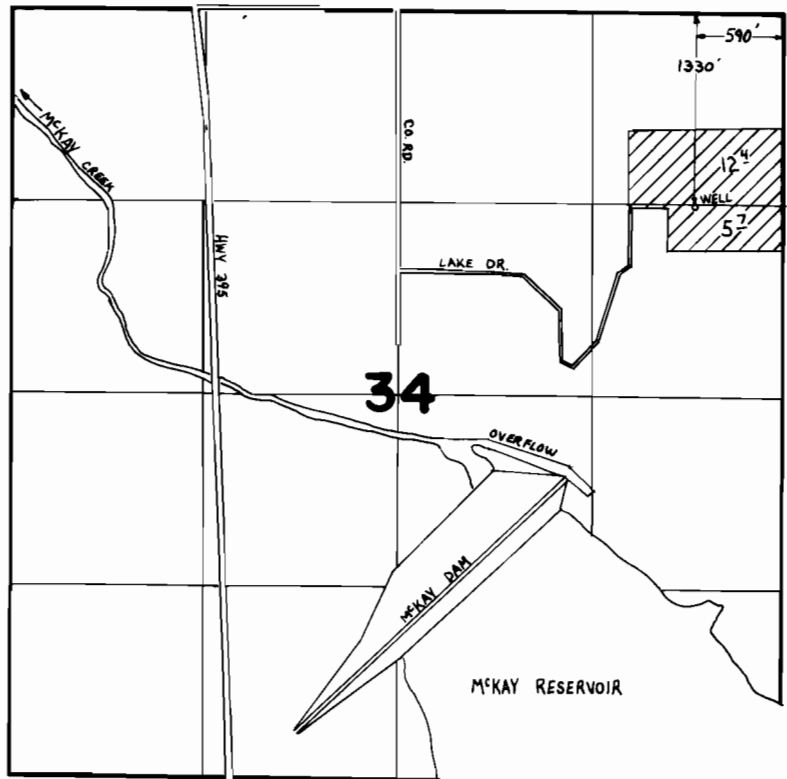

Scale 1" = 1320'



## FINAL PROOF SURVEY UNDER

Application No. G10143. Permit No. G.9221.....  
IN NAME OF

**DANNY RAY & PERRIE KIM SMITH**

Surveyed Nov. 13, 1986, by V. Church.....