


T. 35 S., R. 6 W., W. M.

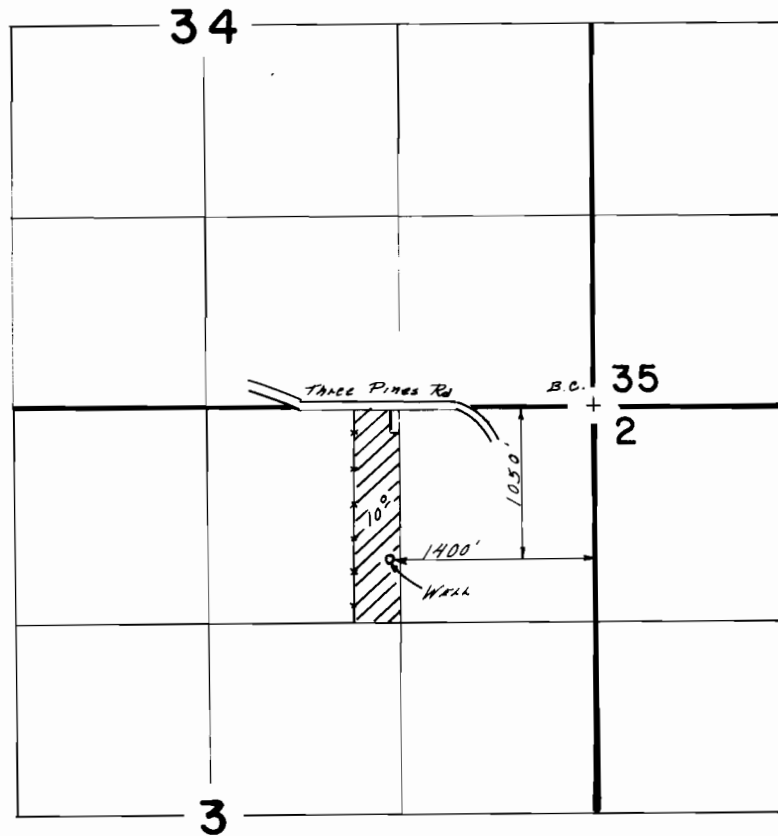

SCALE:
1" = 1320'

FINAL PROOF SURVEY
UNDER

Application No. G-10153 Permit No. G-9247
IN NAME OF

CHARLYN & VIRGIL L. WITCHER

Surveyed AUG. 25. 19.86, by B.S. JAMES....