


# T.15S. R.16E. W.M.

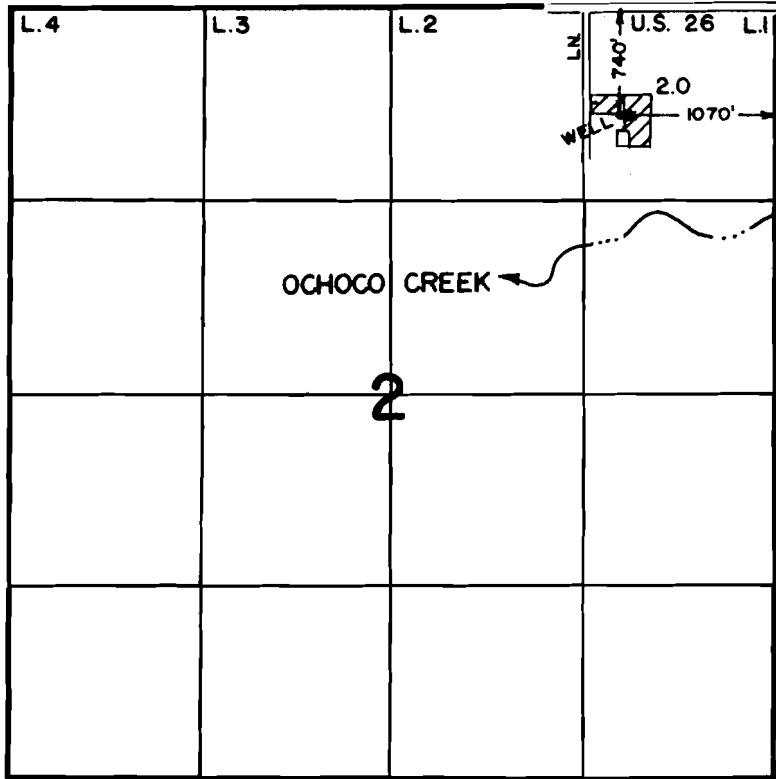

## FINAL PROOF SURVEY UNDER

Application No. ~~G-10260~~ Permit No. ~~G-9416~~.....  
IN NAME OF

*Cert. # 61393*

**ALAN B. COATES**

Surveyed JUL. 20 1982., by L.H. NUNN.....

RECEIVED  
DATE 6-7-89  
WATER MASTER DISTRICT #11  
BY DMJ