
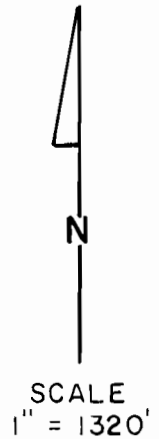


T. 5 S., R. 4 W. WM.

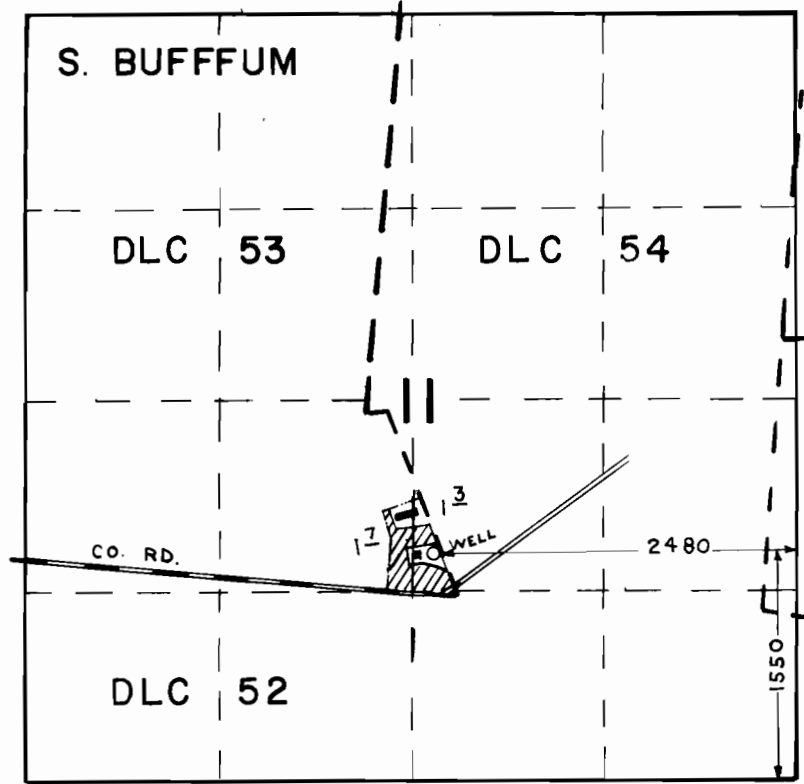

**FINAL PROOF SURVEY**  
UNDER

Application No. G 10299 Permit No. G 9413  
IN NAME OF

LAWRENCE E. GRADEK

Surveyed AUG 22, 1984, by P. PAGTER