


T. 5S., R. 2W., W. M.

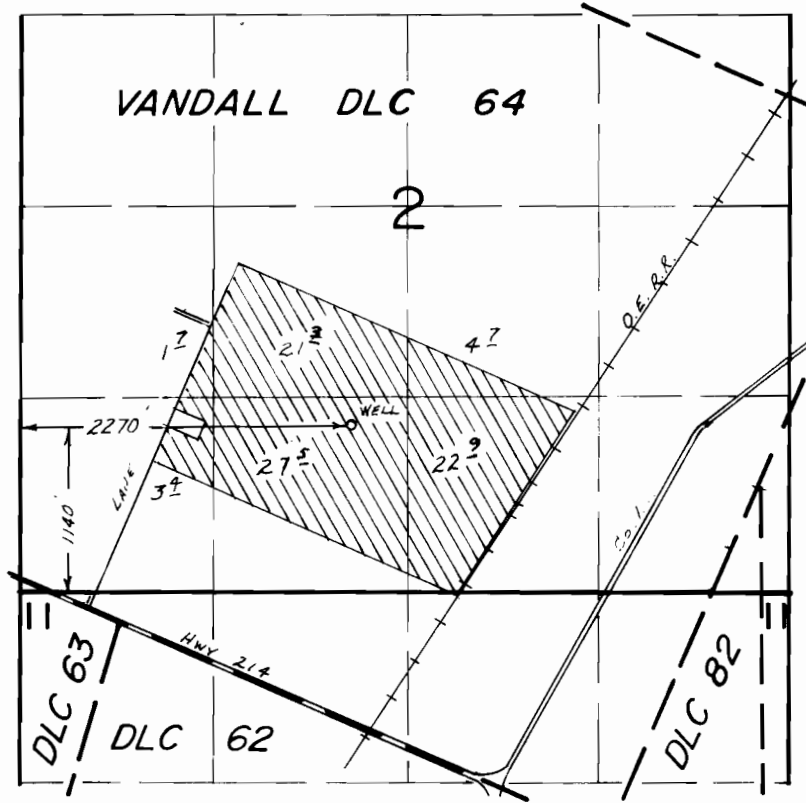

**FINAL PROOF SURVEY**  
UNDER

Application No. G-10337.. Permit No. G-9338.....

IN NAME OF

JULIAN T. & MARCOS T. RUIZ.....

Surveyed Sept. 30... 1983... by L. M. TOLL.....