
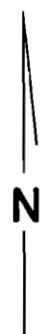


T. 36 S., R. 3 W., W. M.

Sec. 35

SW 1/4 NE 1/4

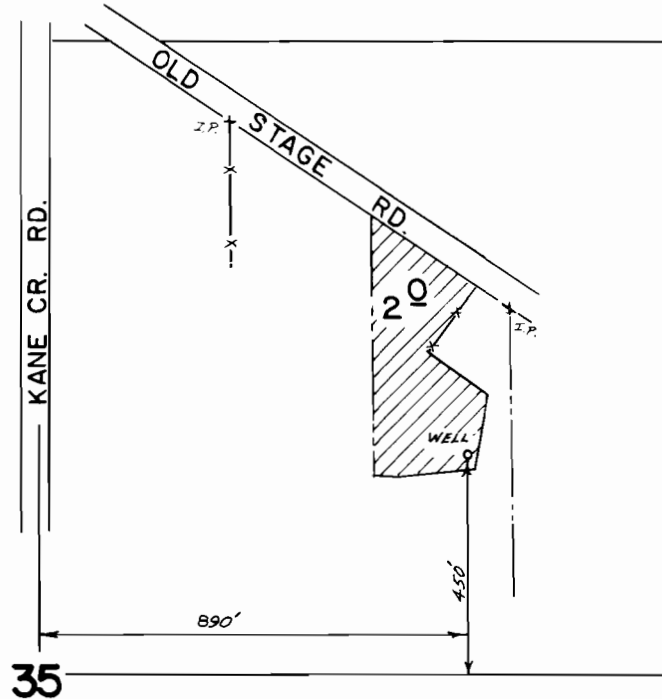

Scale 1" = 400'

FINAL PROOF SURVEY
UNDER

Application No. G-10543.. Permit No. G-9478..
IN NAME OF

LARRY D. &/OR JUNE A. WEBB.....

Surveyed JUNE 25, 1986, by B.S. JAMES.....