


# T. 8 S., R. 2 W., W.M.

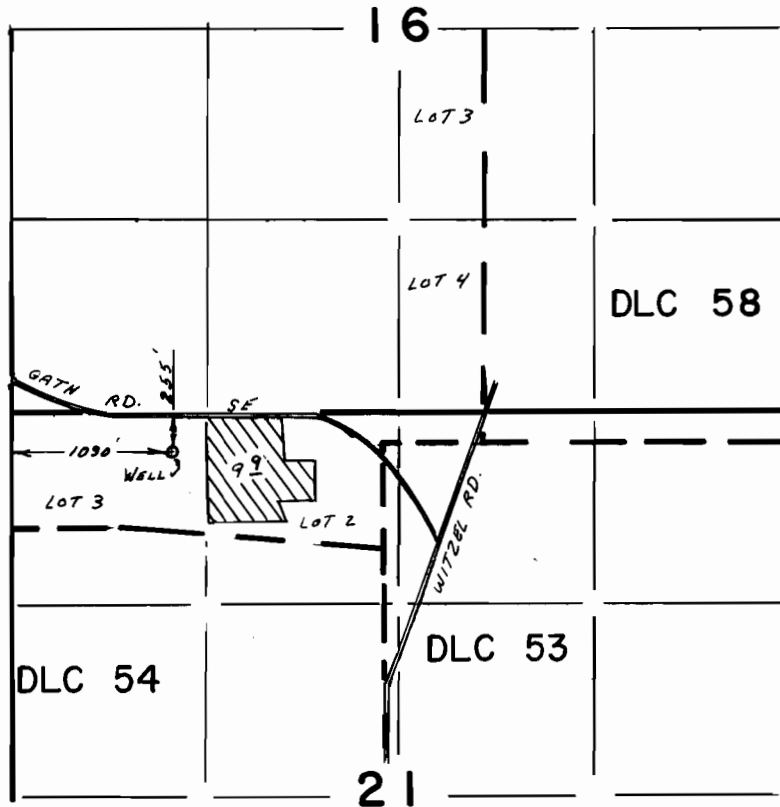

SCALE 1" = 1320'

## FINAL PROOF SURVEY UNDER

Application No. G-11033 Permit No. G-10197...  
IN NAME OF

RICHARD T. & OSIE N. VANSANTEN

Surveyed JUL 7 1988, by Z. SALEH