


T. 2 S., R. 2 W., W. M.

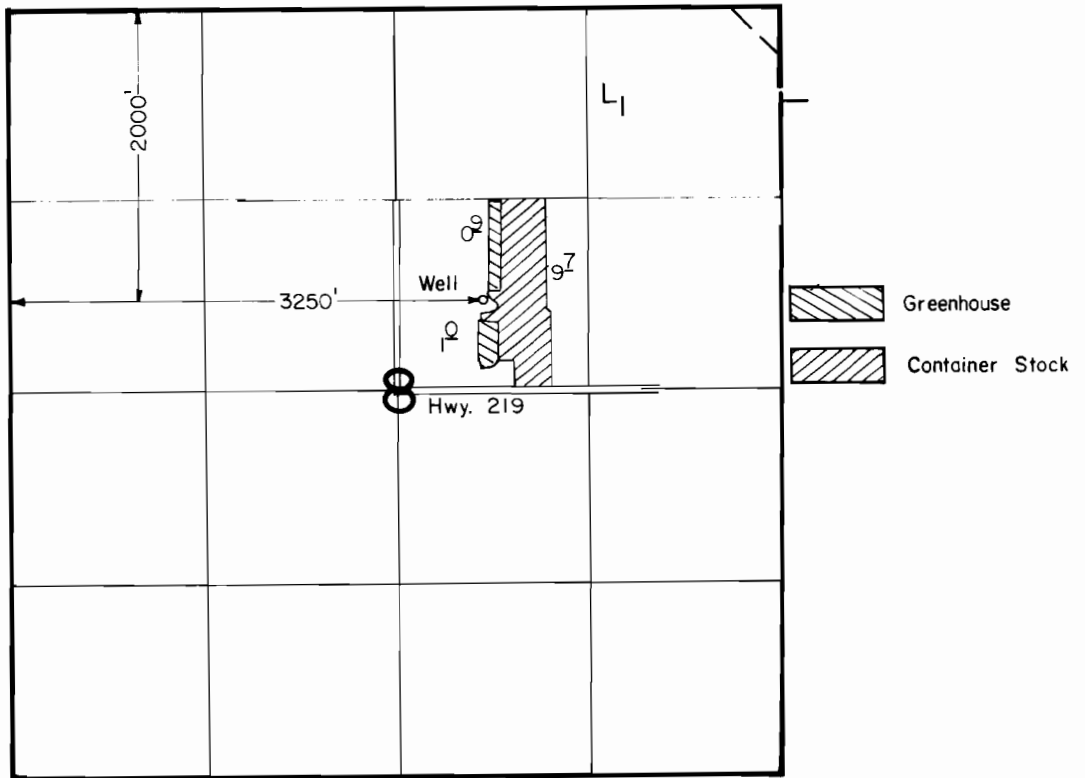

Scale : 1" = 1320'

FINAL PROOF SURVEY
UNDER

Application No. G-11225.. Permit No. G-10427..
IN NAME OF

.....**GLENN A. WALTERS**.....

Surveyed JULY 7... 1988... by T. Warren.....