


T. 9 S., R. 3 W., W.M.

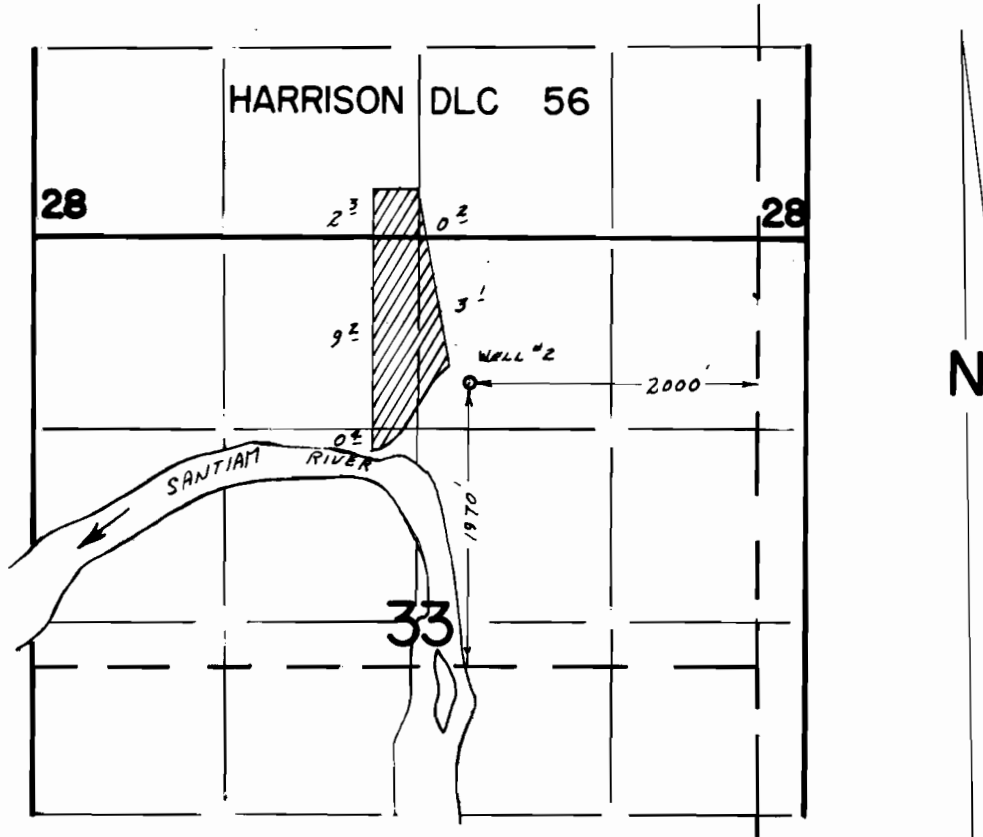

SCALE 1" = 1320'

FINAL PROOF SURVEY

UNDER

Application No. G-11360 Permit No. G-10485...
IN NAME OF

ELMER L. COOK

Surveyed JUL 20 88 by Z. SALEH