


T. 5 S., R. 1 E., W. M.

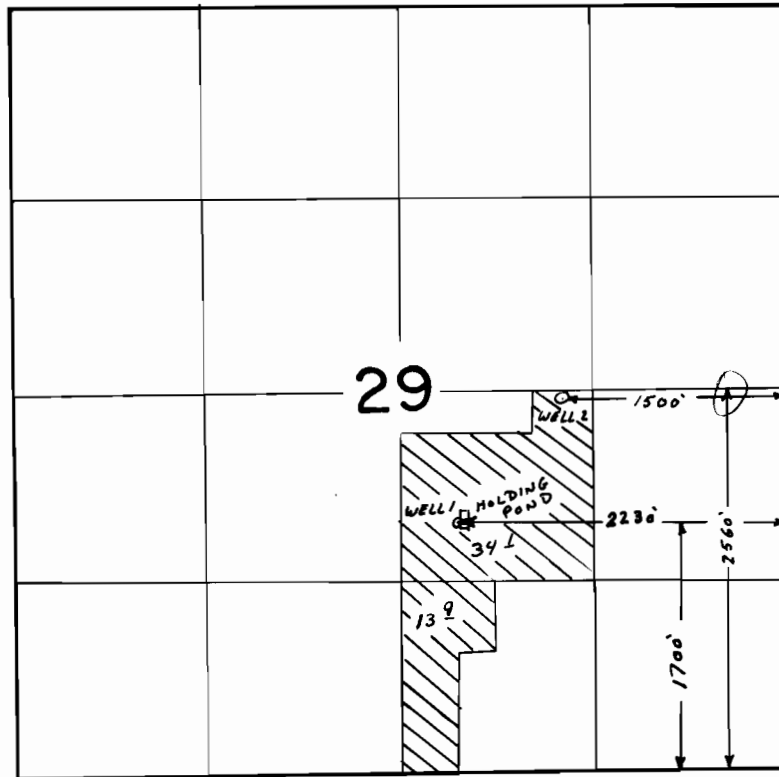

SCALE 1" = 1320'

FINAL PROOF SURVEY
UNDER

Application No. G-11602 Permit No. G-10714
IN NAME OF

ROBERT FESSLER

Surveyed SEP 17 1987, by T. WARREN