


T. 11 S., R. 10 W., W. M.

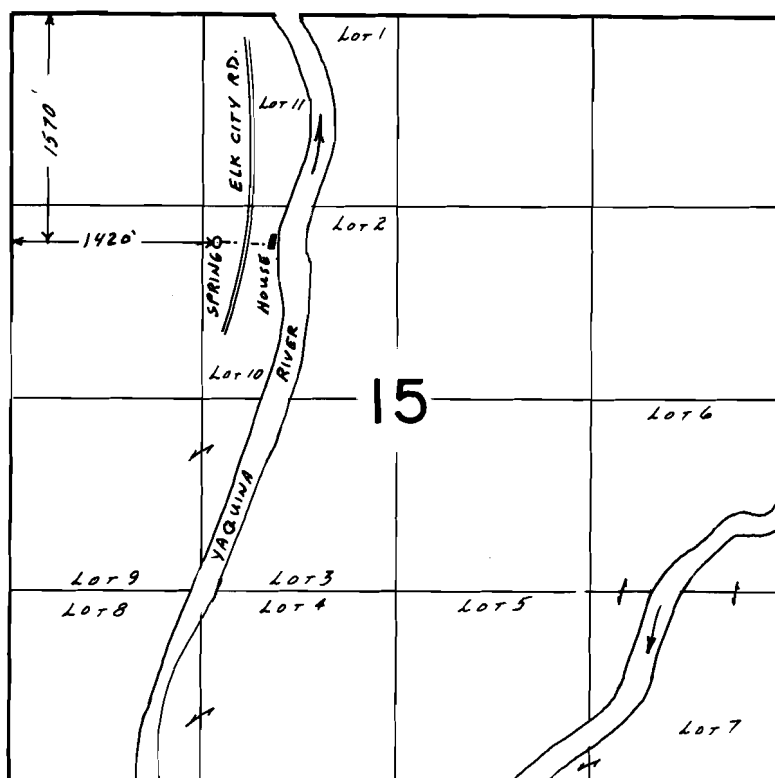

SCALE 1" = 1320'

FINAL PROOF SURVEY
UNDER

Application No. 50256 Permit No. 37929
IN NAME OF

GLENN WARFIELD

Surveyed JUL 28 1988, by Z. SALEH

41041-272-110
1-26-89 Z. f.s.