


T.18S., R. 45E., W. M.

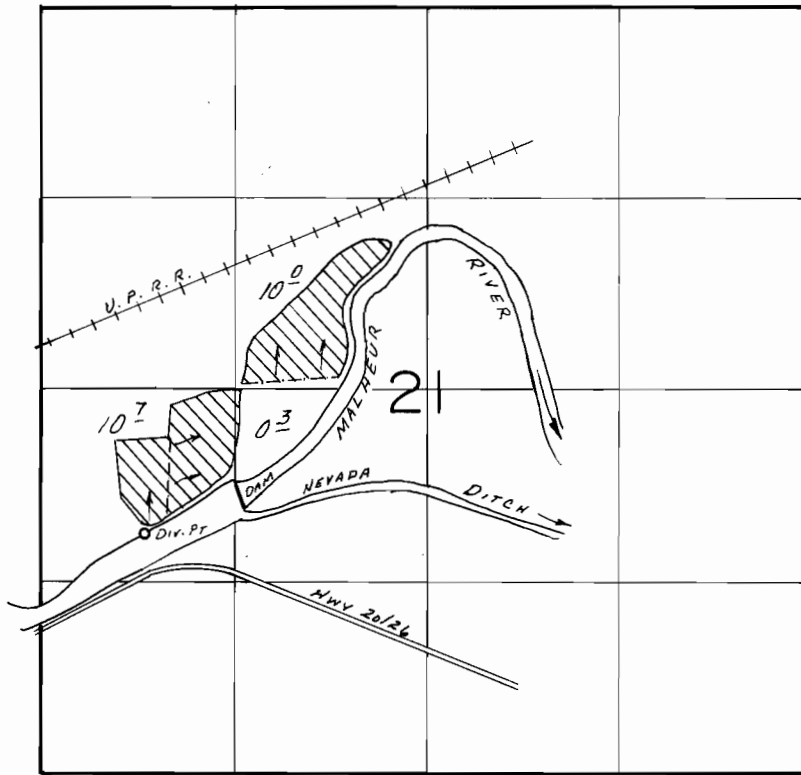

DIV. PT. LOC.: 1650' N. & 700' E. FROM SW COR. SEC. 21.

SCALE: 1" = 1320'

FINAL PROOF SURVEY UNDER

Application No. 50354... Permit No. 38013.....

IN NAME OF

CITY OF VALE.....

Surveyed Apr. 15..... 19.86, by L. M. TOLL.....