


# T.16S. R.5 W. W.M.

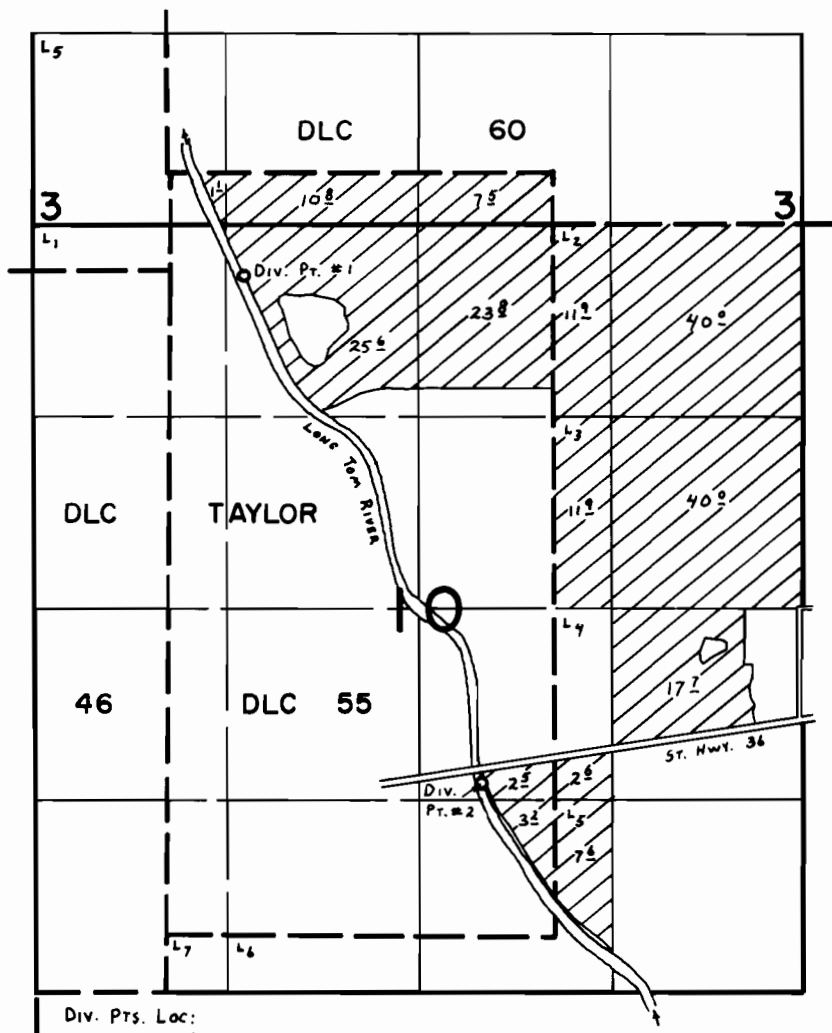

Div. Pts. Loc:

#1- 710'S. & 510'E. fr. N.W. COR. TAYLOR DLC 55.

#2- 1080'N. & 490'W. fr. S.E. COR. TAYLOR DLC 55.

## FINAL PROOF SURVEY

UNDER

Application No. 50397 Permit No. 38037.....

IN NAME OF

ROBERT S. NELSON.....

Surveyed June 20 1979, by C. L. HUGHES.....