


T.26S. R.5W. W.M.

Sec. 26

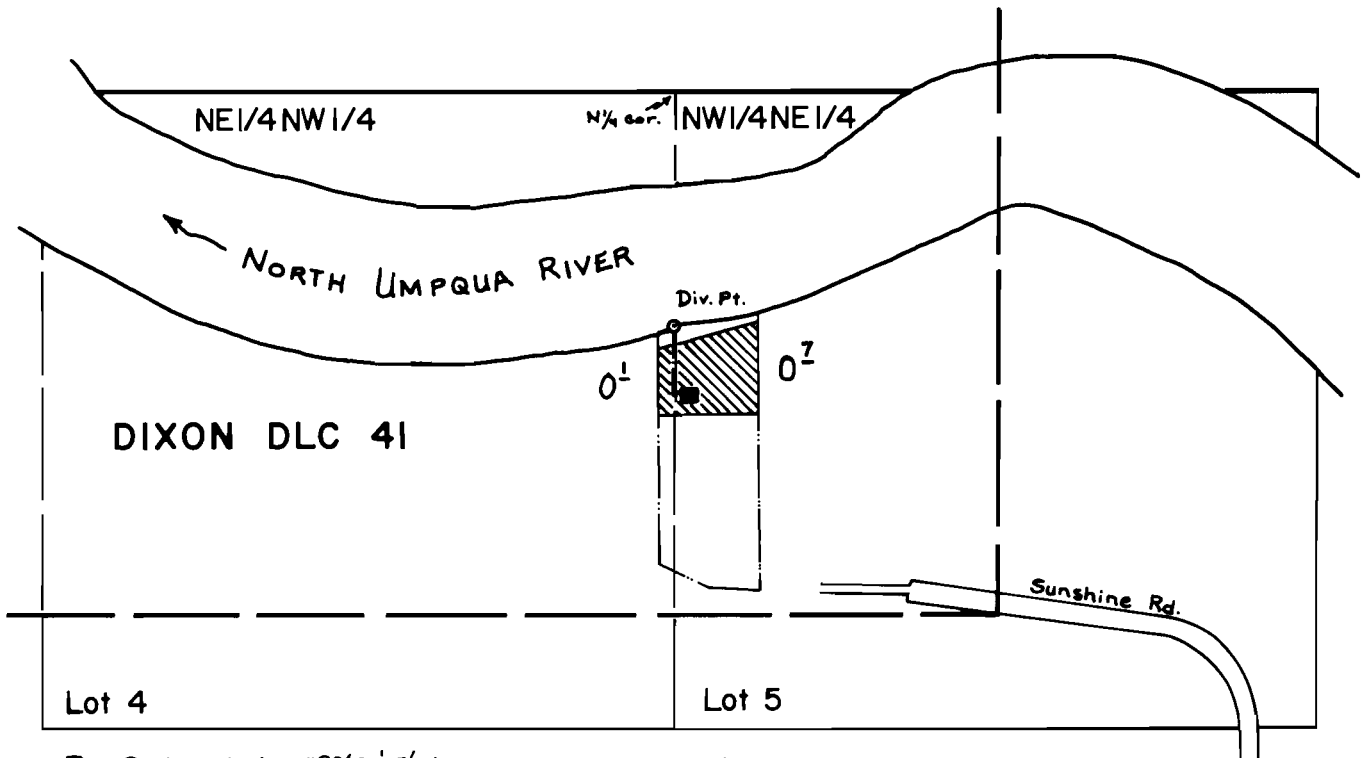

Div. Pt. Located: 490' S $\frac{1}{2}$ 5' W from N $\frac{1}{4}$ cor., Sec. 26

OAK-LAWN ACRES

Lots 6 & 7

SCALE: 1" = 400'

FINAL PROOF SURVEY

UNDER

Application No. 50714 Permit No. 38304
IN NAME OF

.....JOHN MALONE & CAROL MALONE.....

Surveyed April 30, 1979, by S. Donaldson.....