


T. 10S., R. 9W., W.M.

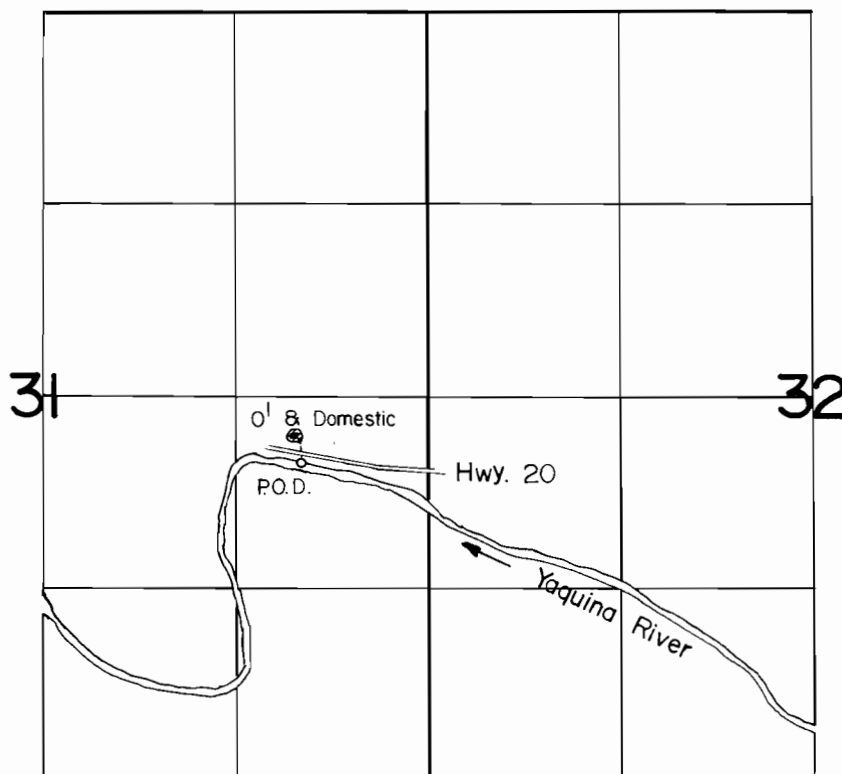

P.O.D. Loc. : 460' S. & 870' W. from E. 1/4 Cor. Sec. 31.

Scale: 1" = 1320'

FINAL PROOF SURVEY UNDER

Application No. 51903, Permit No. 39058....
IN NAME OF

ERNESTO E. & HAYDEE SERROT

Surveyed AUG. 7.... 1986., by T. Warren.....