




T. 26 S., R. 11 W., W.M.

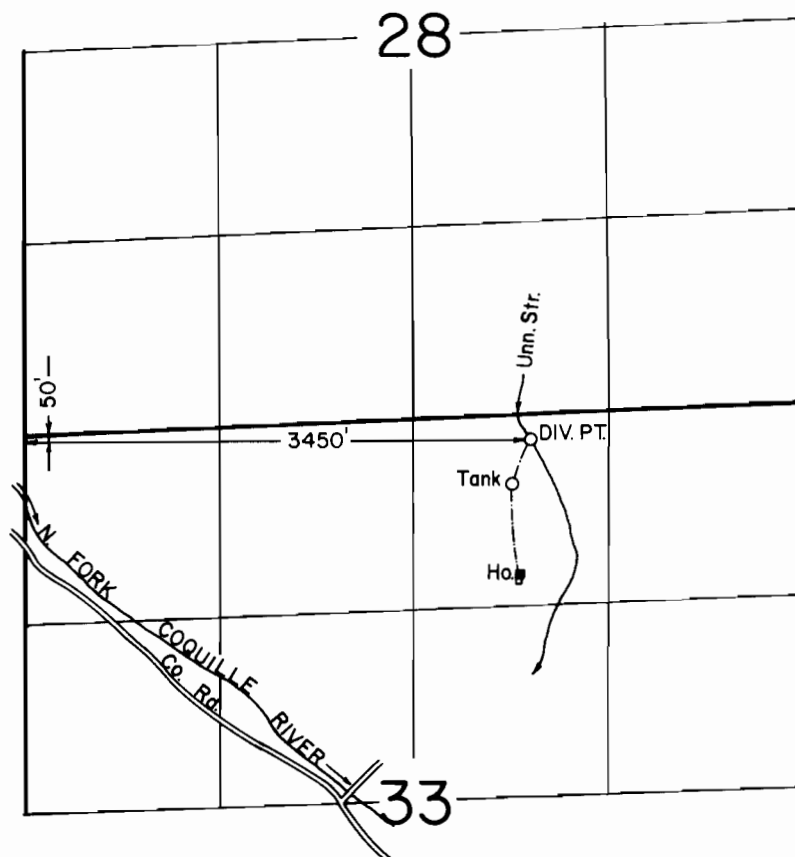

SCALE: 1" = 1320'

FINAL PROOF SURVEY
UNDER

Application No. 52087. Permit No. 39246.....
IN NAME OF

RANDALL JAMES TURNER.....

Surveyed SEPT. 21, 1988., by Z. SALEH.....