


T.7N., R4W., W.M.

Sec. 3

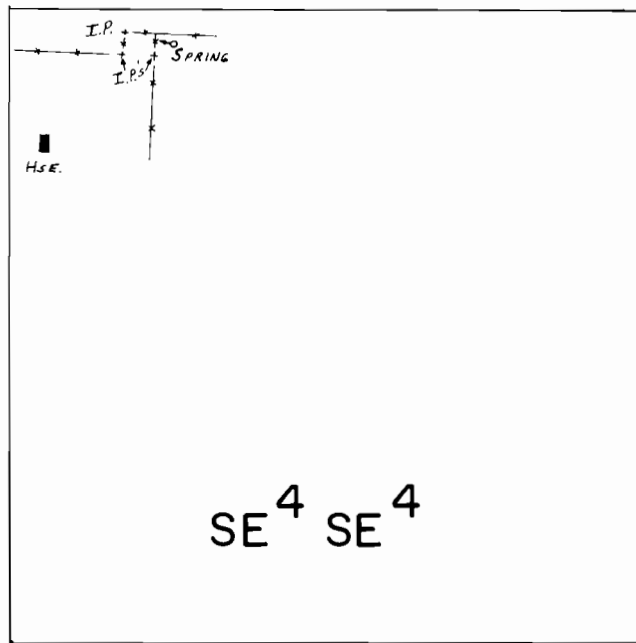

Spring Loc. : 1250' N. & 980' W. from SE Cor. Sec. 3.

Scale : 1" = 400'

FINAL PROOF SURVEY UNDER

Application No. 52142... Permit No. 39387.....
IN NAME OF

WARREN L. & MARY D. NAILLON

Surveyed AUG. 25. 1977., by S.C. BROWN.....

PTS-1977-L + L.D.
TMW 1/8/87