


T.24S. R.4W. W.M.

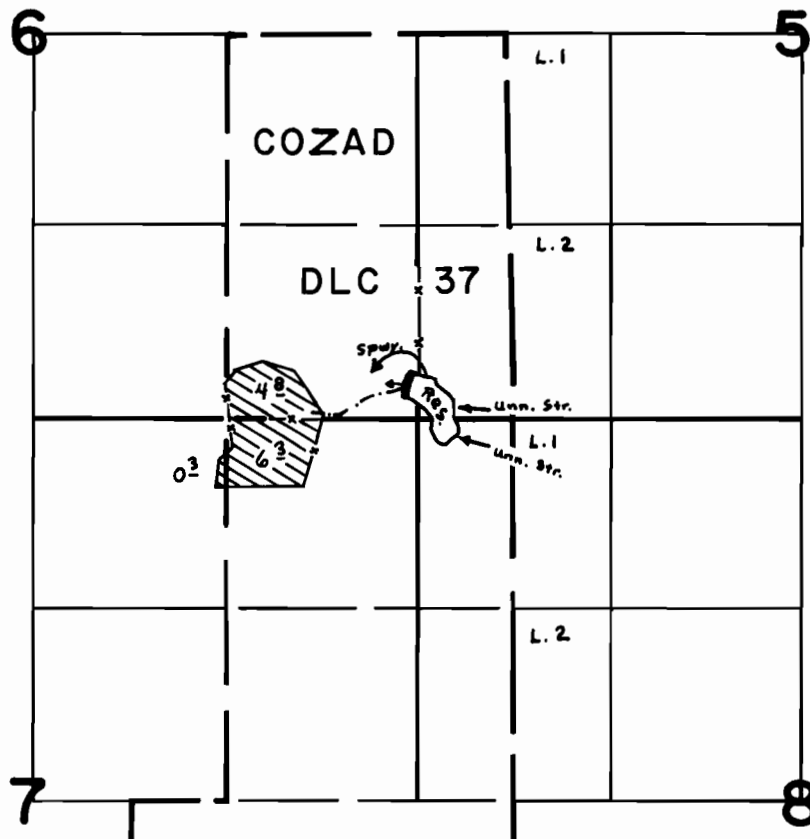

Dam Located: 250' N 1/2 50' W from the SE cor. of Sec. 6

SCALE: 1" = 1320'

FINAL PROOF SURVEY
UNDER

R-52221 R-6090
Application No. 52222 Permit No. 37530
IN NAME OF
THOMAS E. LINDBLOOM & CLIFFORD M. BRYDEN
dba MORE MOUNTAIN RANCH

Surveyed MAY 31 1978, by D. Sparks