


T.16S. R.7W. W.M.

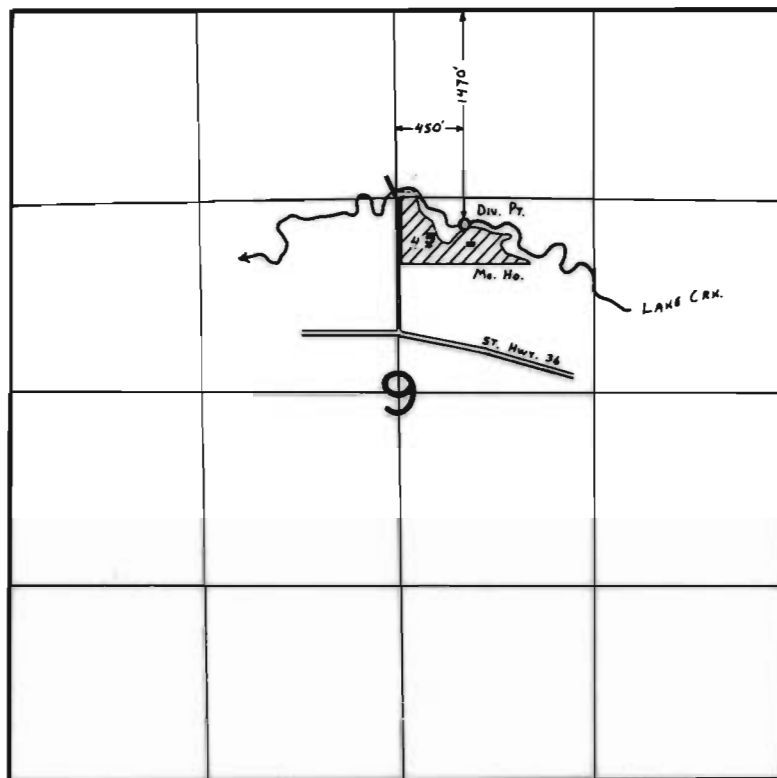

FINAL PROOF SURVEY
UNDER

Application No. 52762, Permit No. 39839.....
IN NAME OF

HAROLD A. & ALPHA B. MCGARVIN

Surveyed June 20 1979, by C. L. HUGHES.....