


# T.9S. R.3W., W.M.

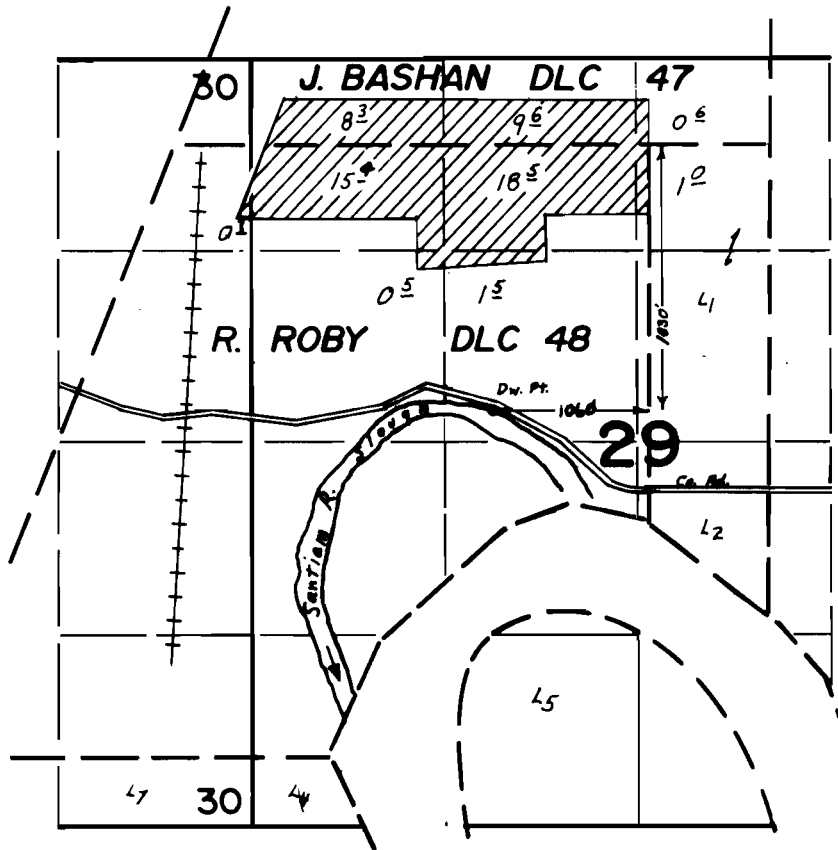

## FINAL PROOF SURVEY UNDER

Application No. ~~52799~~... Permit No. ~~39853~~.....  
IN NAME OF

VERNON W. & DOROTHY B. MEYER

Surveyed MAY 15... 1979., by L. H. NUNN.....