


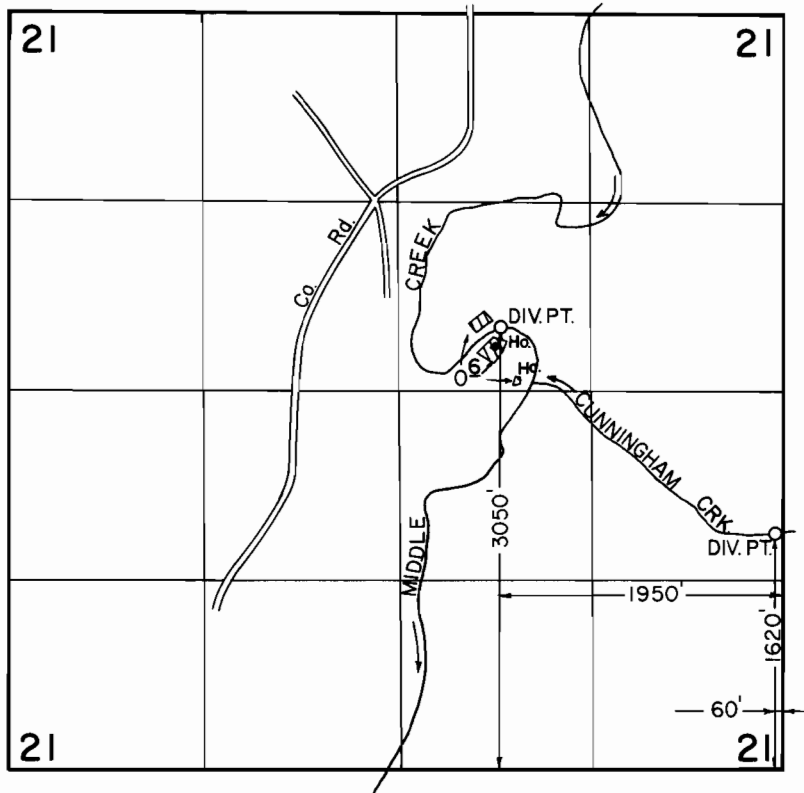

T.27S.,R.11W.,W.M.



SCALE: 1" = 1320'

**FINAL PROOF SURVEY**  
UNDER

Application No. 52881... Permit No. 39909.....  
IN NAME OF

**GENTRY FARM ENTERPRISES, INC.**

Surveyed SEPT. 18, 1988, by Z. SALEH.....

Revised: 3-2-89

41011-280-51L