


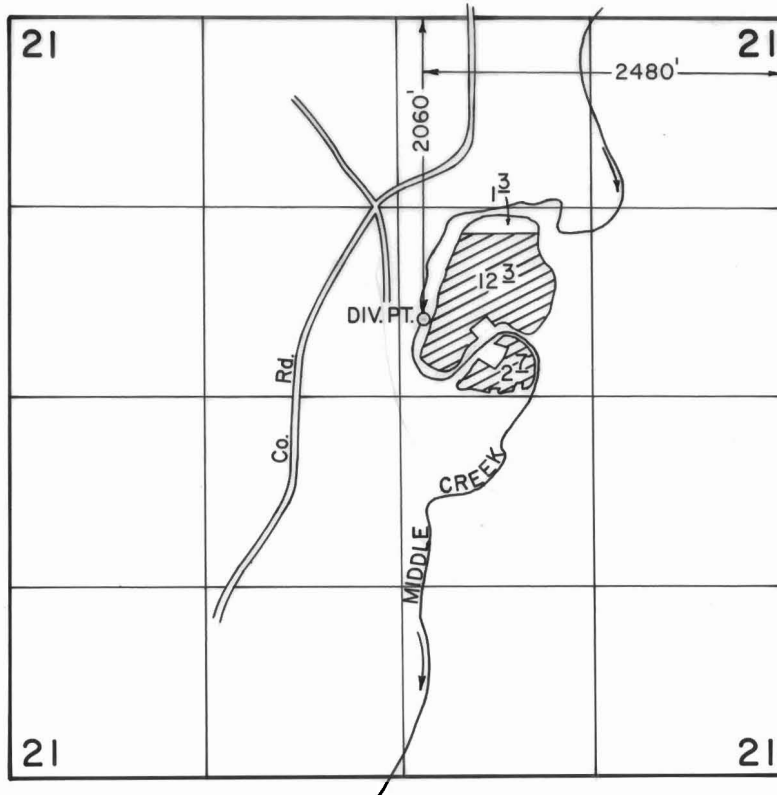

T. 27 S., R. 11 W., W.M.



SCALE: 1" = 1320'

**FINAL PROOF SURVEY**  
UNDER

Application No. 60728. Permit No. 45413  
IN NAME OF

**GENTRY FARM ENTERPRISES, INC.**

Surveyed SEPT. 18, 1988, by Z. SALEH