


T. 36 S., R. 6 W., W. M.

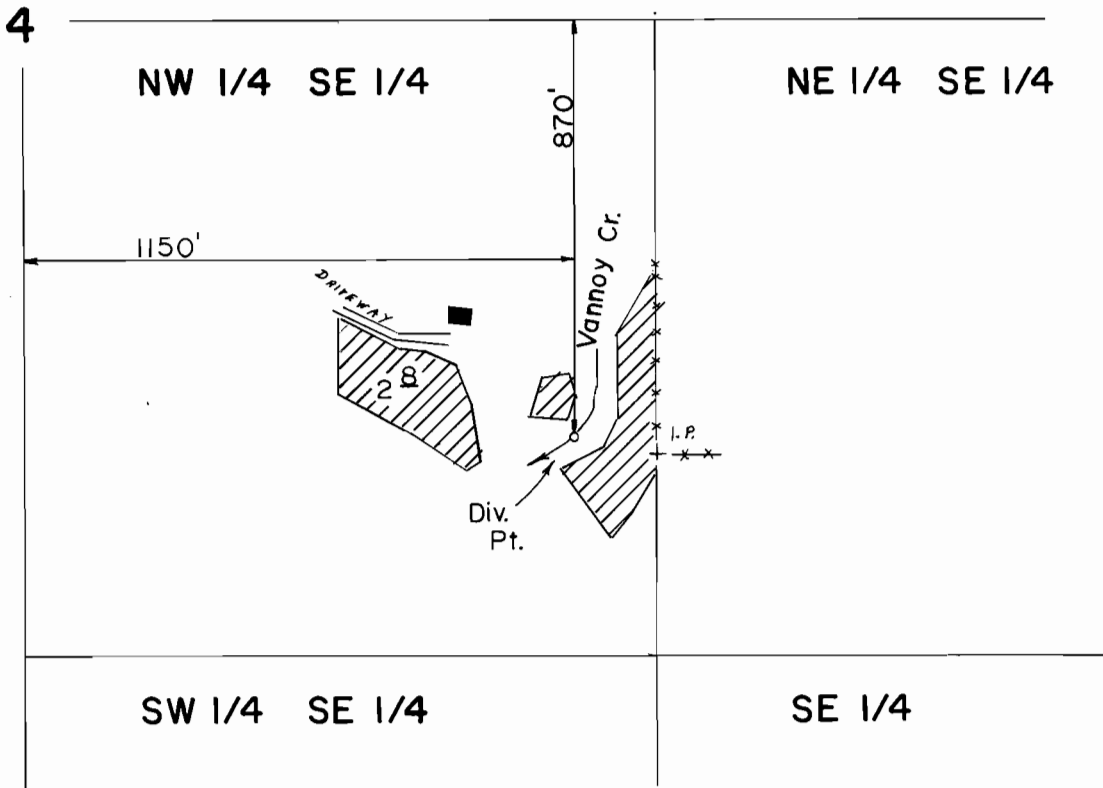

Scale: 1" = 400'

FINAL PROOF SURVEY UNDER

Application No. 53226 Permit No. 39498
IN NAME OF

.....GEORGE A. CALVERT.....

Surveyed SEP..16.. 1987, by B..S.....JAMES.