


T. 5 S., R. 6 W., W. M.

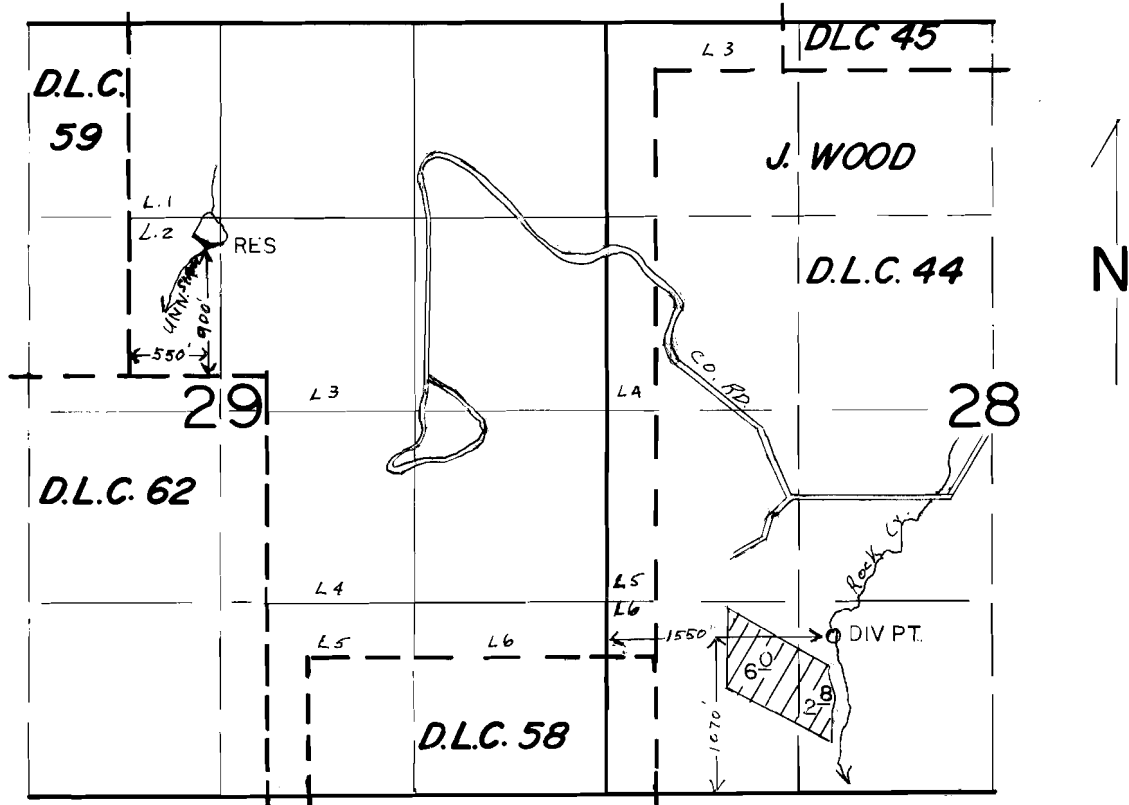

SCALE: 1" = 1320'

FINAL PROOF SURVEY
UNDER

R-53780 R-6436
53781 40383
Application No. 53452... Permit No. 39770.....
IN NAME OF

.....THE DELPHIAN FOUNDATION.....

Surveyed SEP. 14... 1987., by B.W. BISHOP.....