


T. 15., R. 3W., W.M.

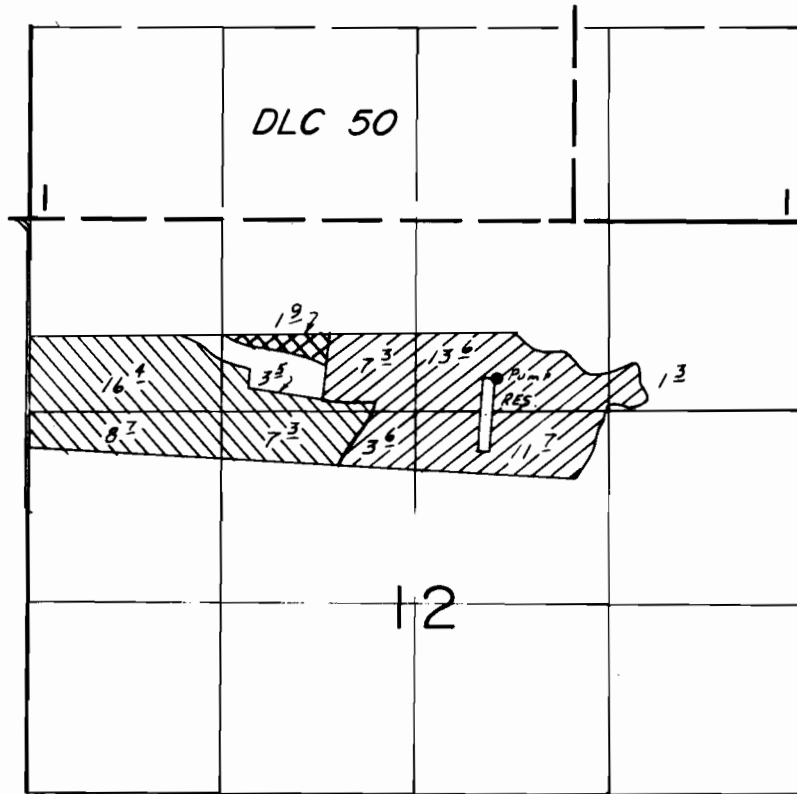

DIV. PT. LOC.: 1340'S. & 2160' W. FROM NE COR. SEC. 12.

SCALE: 1" = 1320'

FINAL PROOF SURVEY

UNDER

R-53553

R-6195

SUPPLEMENTAL

PRIMARY

53554

38413

Application No. 54960. Permit No. 41206.....

IN NAME OF

.....E.R.P.MAN.....

Surveyed Aug. 13, 1986, by B.W. BISHOP.....

11/7/87
BWB

41067-178-140 B