


T.12S., R.5W., W.M.

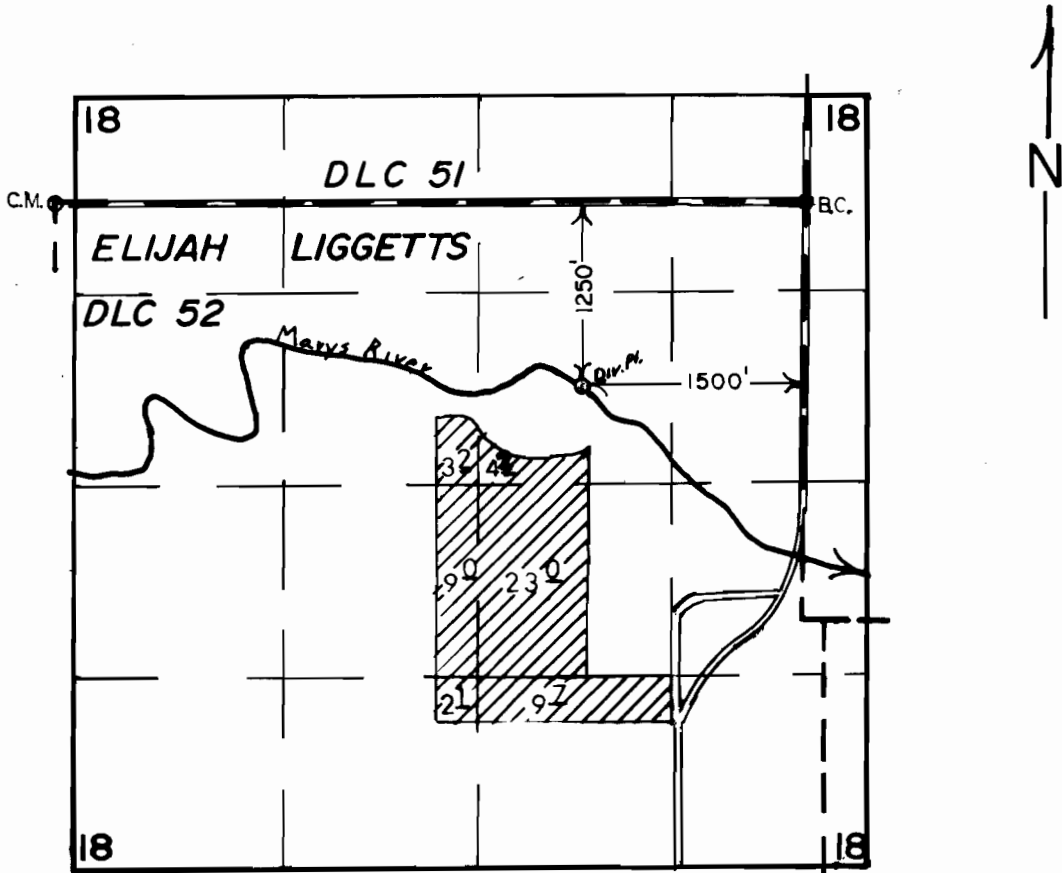

SCALE: 1" = 1320'

FINAL PROOF SURVEY
UNDER

Application No. 53612.... Permit No. 40111.....
IN NAME OF

.....JAMES L. FESSLER.....

Surveyed MAY.4..... 1987., by I.M. WARREN.....