




T.26S.,R.12&13 W.,W.M

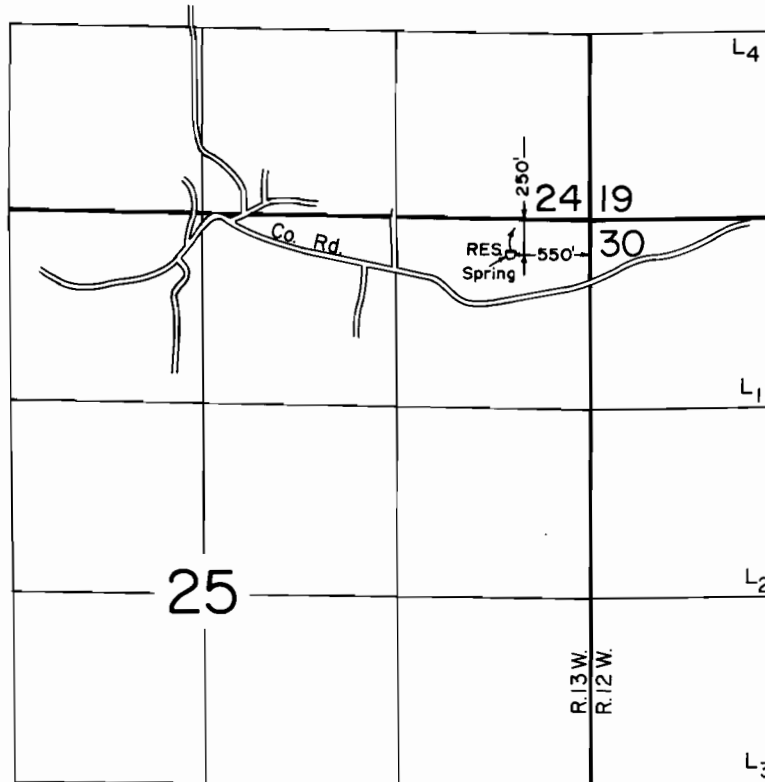

SCALE: 1" = 1320'

**FINAL PROOF SURVEY**  
UNDER

Application No. R-53776 Permit No. R-6412.....  
IN NAME OF

GEORGE M. & EDITH I. MENKEN.....

Surveyed SEPT. 20 1988, by L.H. NUNN.....