


T.11S. R.6 W. W.M.

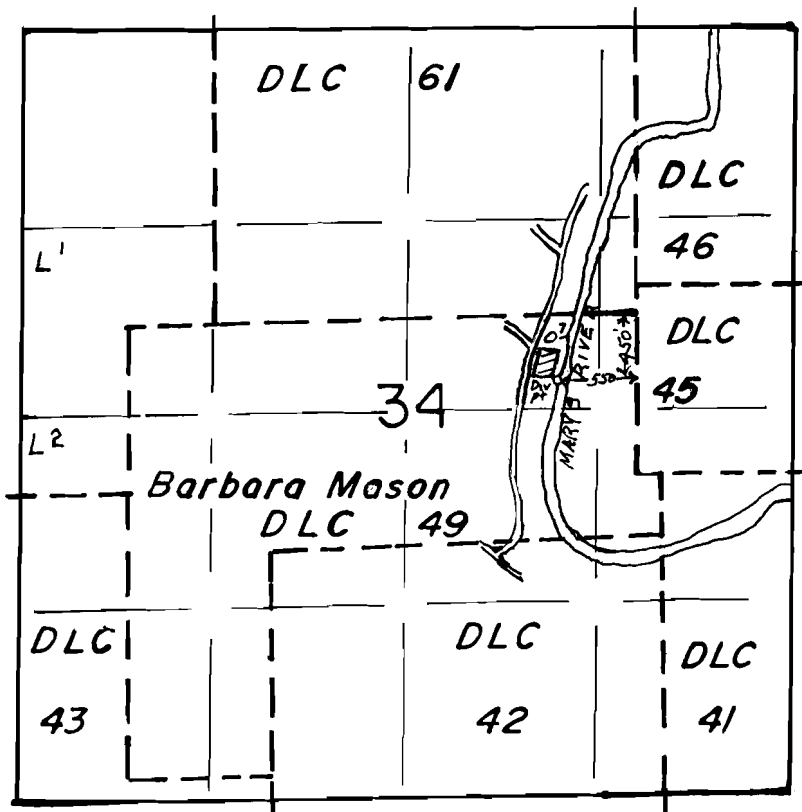

SCALE 1" = 1320'

FINAL PROOF SURVEY UNDER

Application No. **54406** Permit No. **40770**.....
IN NAME OF

.....**PATRICK DEAN SERRY**.....

Surveyed **APRIL 24, 1987**, by **J.M. WARREN**.....