


T. 13 S., R. 10 W., W.M.

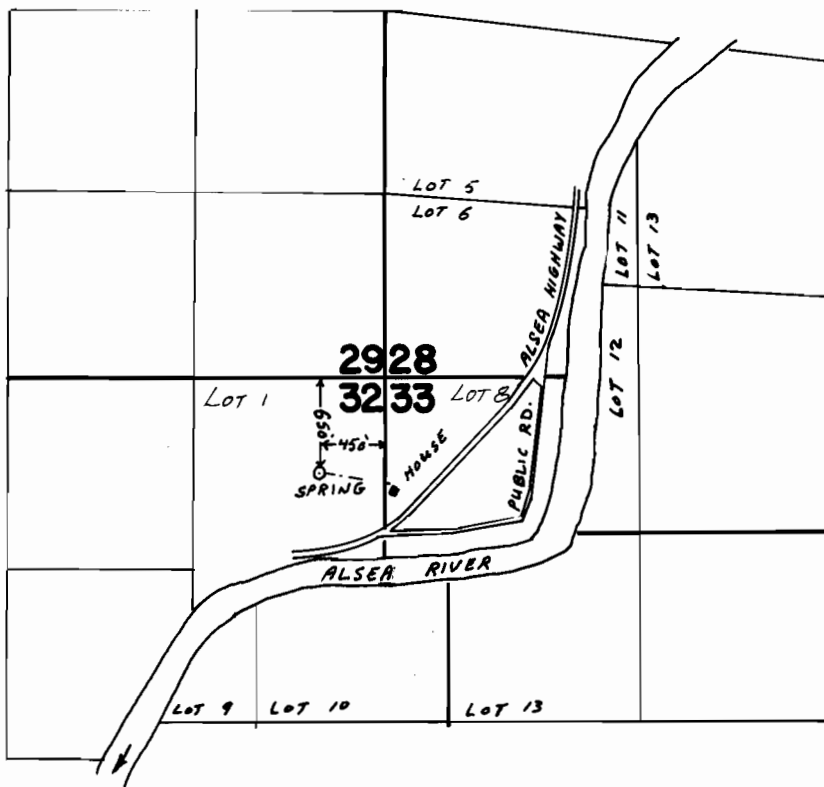

SCALE 1" = 1320'

FINAL PROOF SURVEY UNDER

Application No. **65040** Permit No. **47534**
IN NAME OF

JEFFERY D. & ANNE M. DOOLIN

Surveyed **JUL 26 1988** by **Z. SALEH**