


T. 41 S., R. 12 W., W.M.

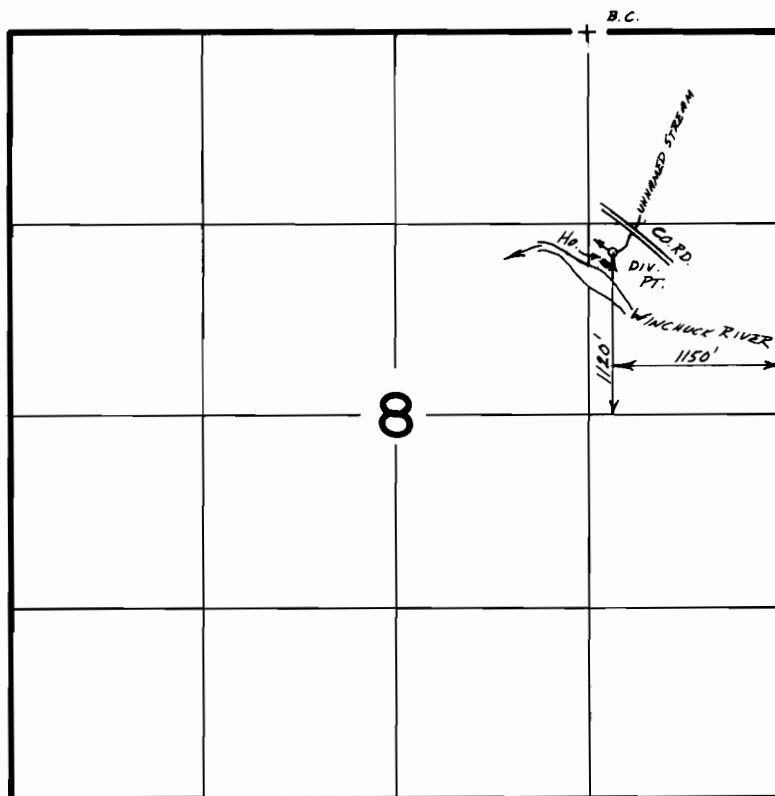

Scale 1" = 1320'

FINAL PROOF SURVEY UNDER

Application No. 55177.. Permit No. 41351.....
IN NAME OF

EARL & JANET.....SCHOUWEILER.

Surveyed May 21, 1987, by J.M. SCHMORDE
Oct. 8, 1988, by B.S. JAMES