



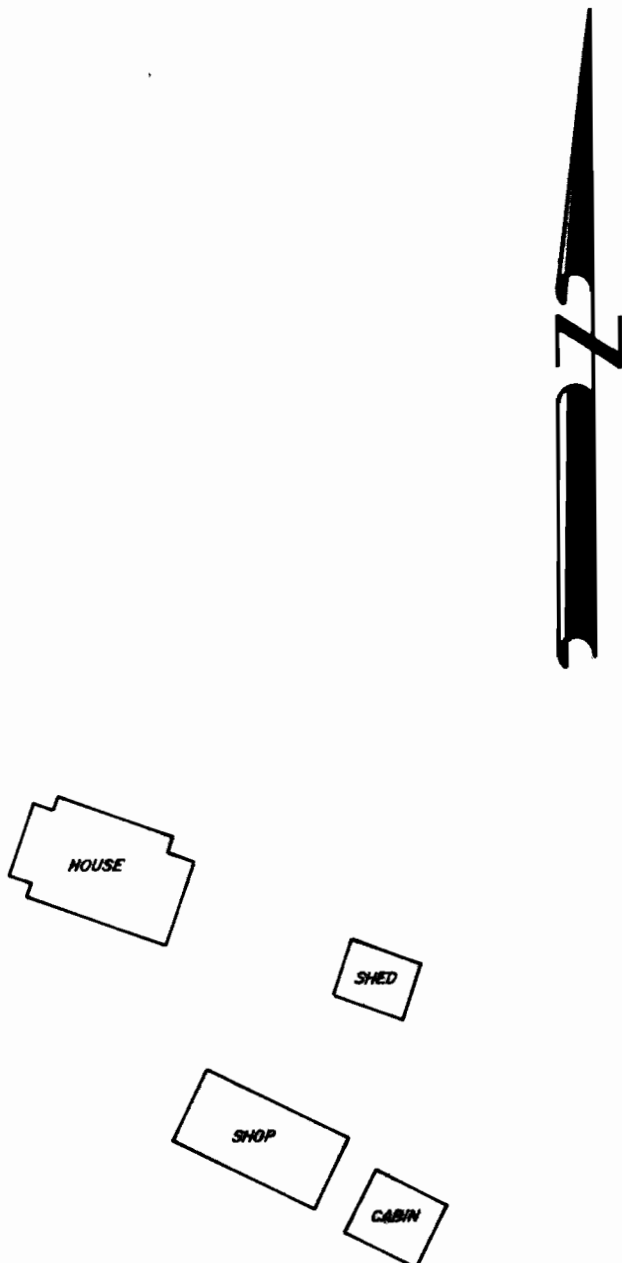


WATER LEVEL - 5111.1

NOTE:
FOR DAM AND SPILLWAY CROSS-SECTIONS
SEE DETAIL SHEET

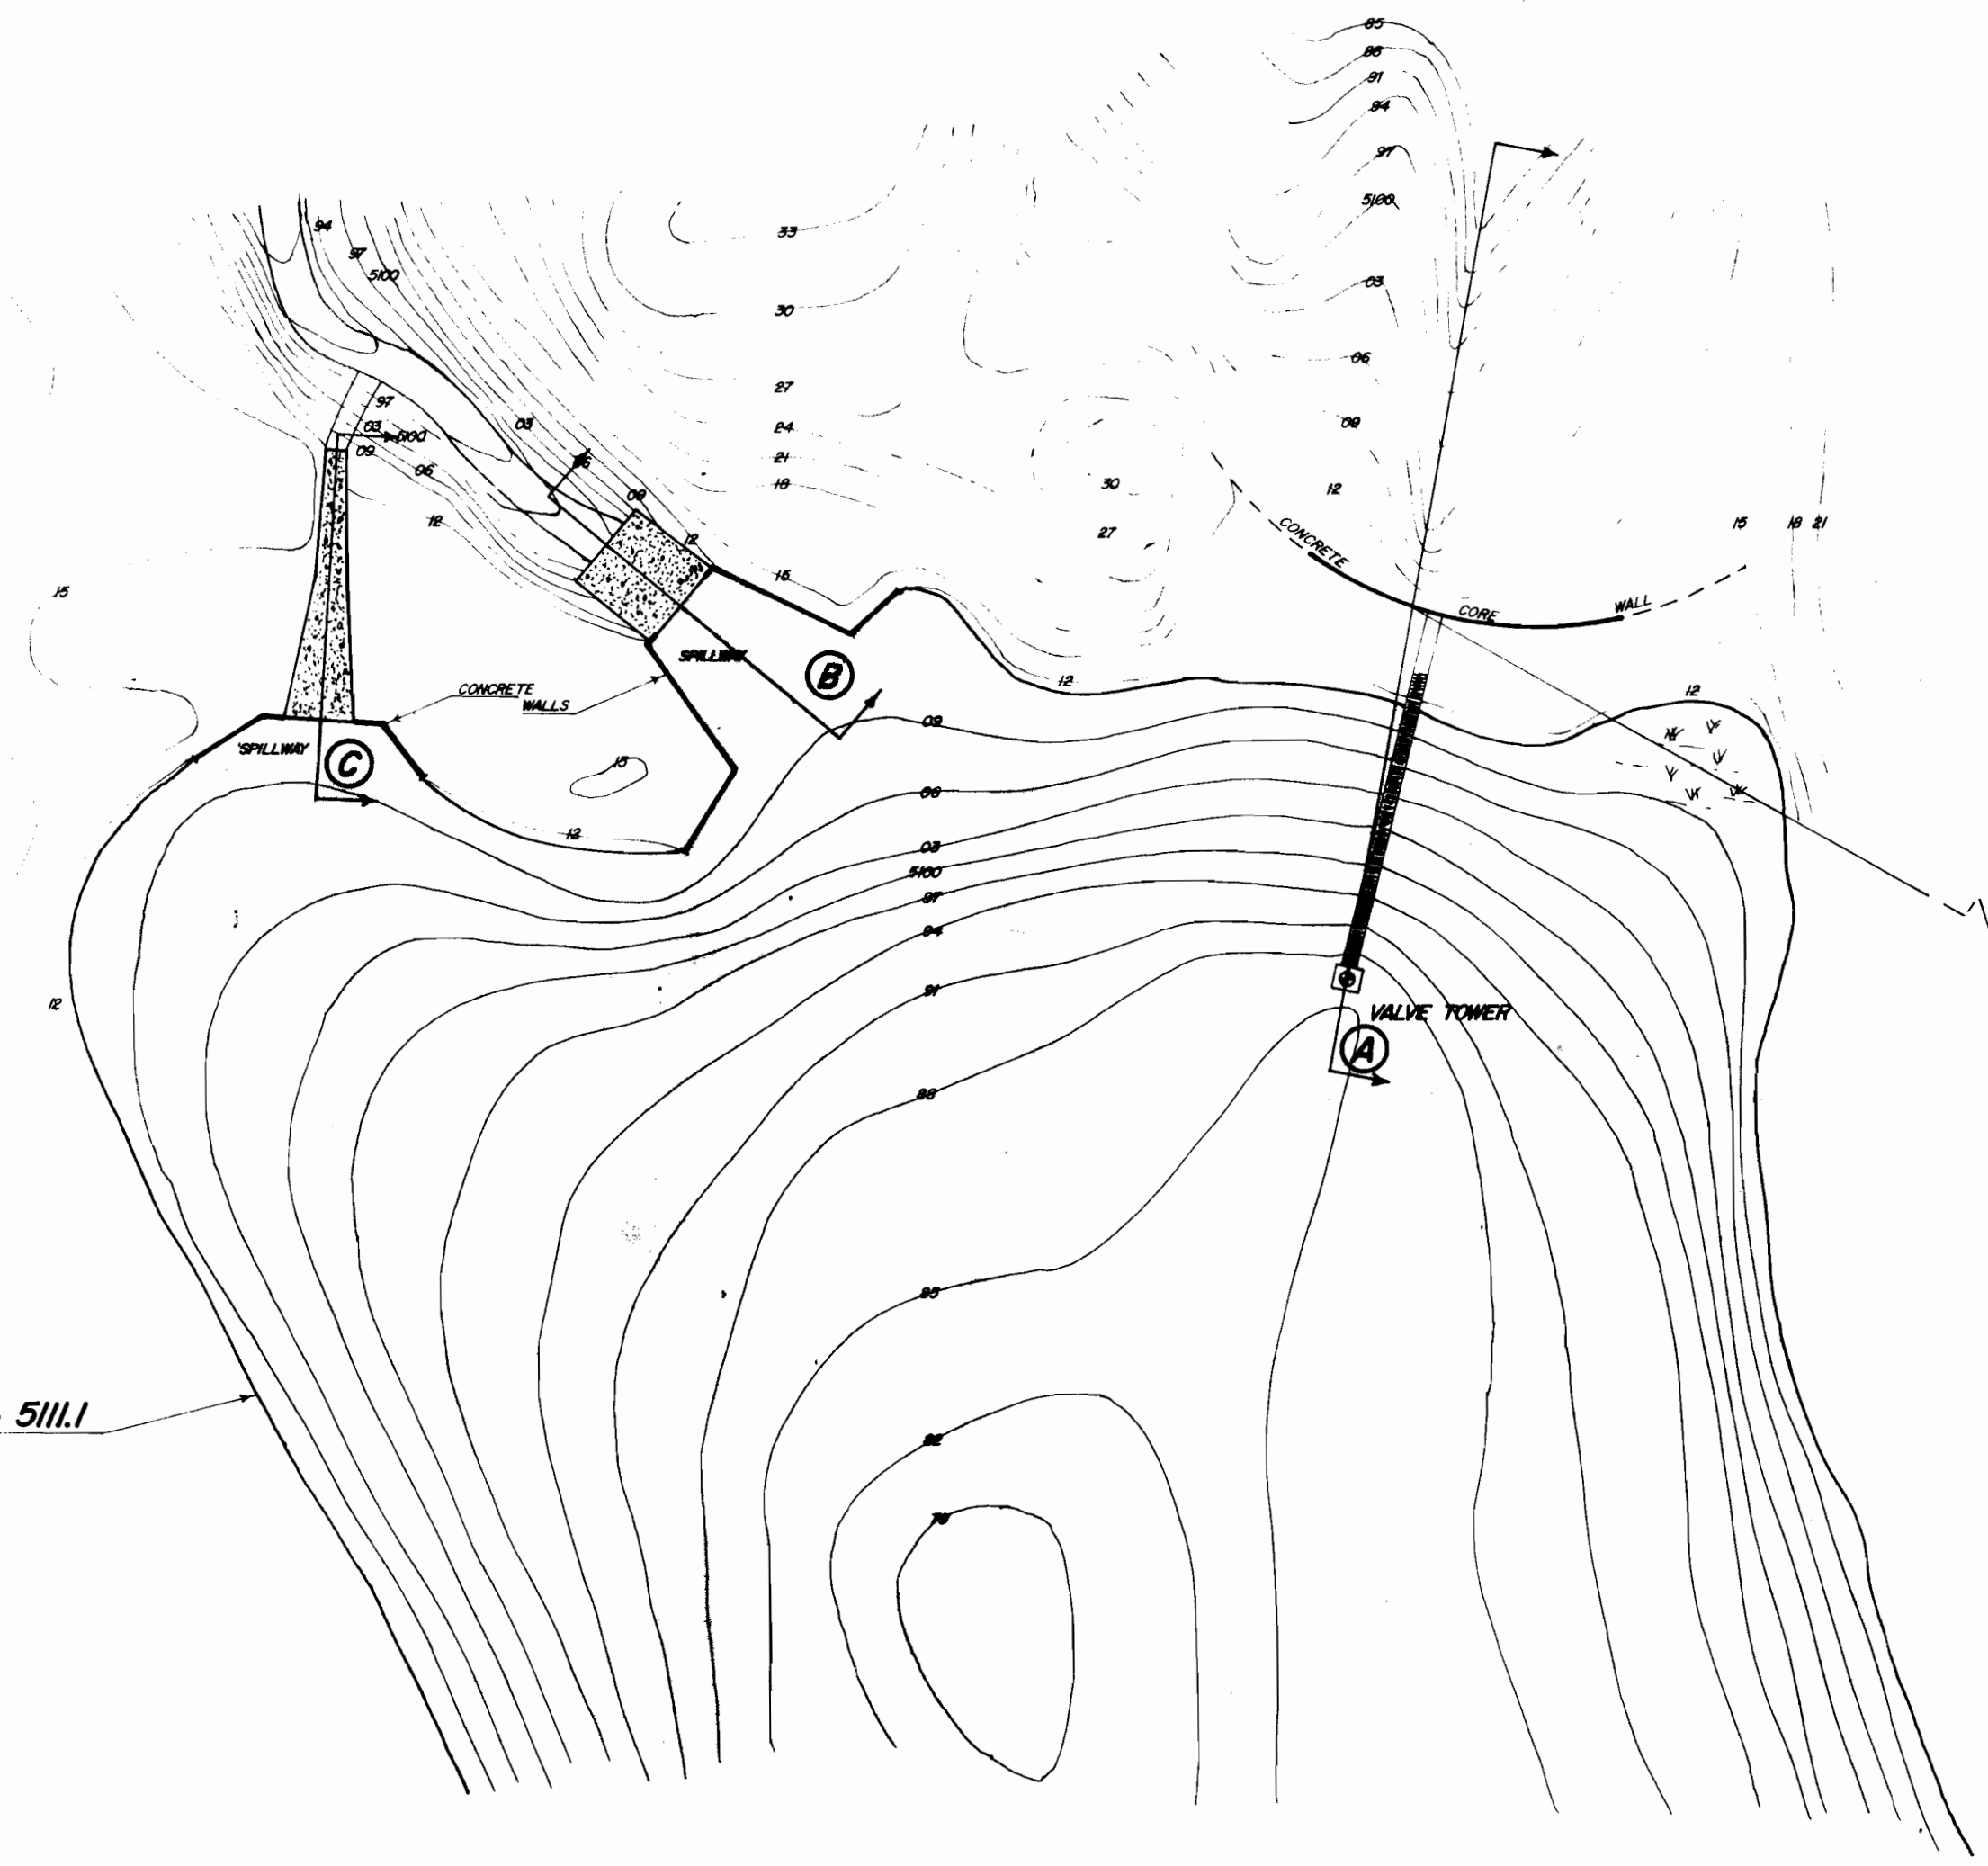

950
1660

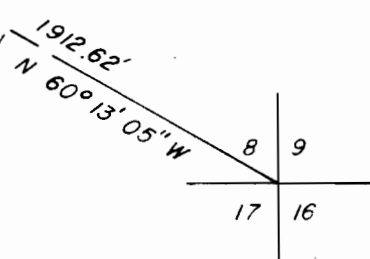

NOTE: Section corner not found this survey. Tie furnished by City of LaGrande.

REGISTERED
PROFESSIONAL
LAND SURVEYOR

Gregory T. Blackman

OREGON
JULY 13, 1973
GREGORY T. BLACKMAN
891



Application No. 18-045
Permit No. 18-045

BAGETT, GRIFFITH & ASSOCIATES La Grande, Oregon Map of Survey		
LAGRANDE RESERVOIR DAM AND SPILLWAYS		
T5S, R37E W.M. UNION COUNTY, OREGON		
SURVEYED FOR	CITY OF LAGRANDE	
SURVEYED BY	GTB	7-78
Scale: 1" = 50'	Drawn by: SSZ	7-78