


T. 41 S., R. 12 W., W.M.

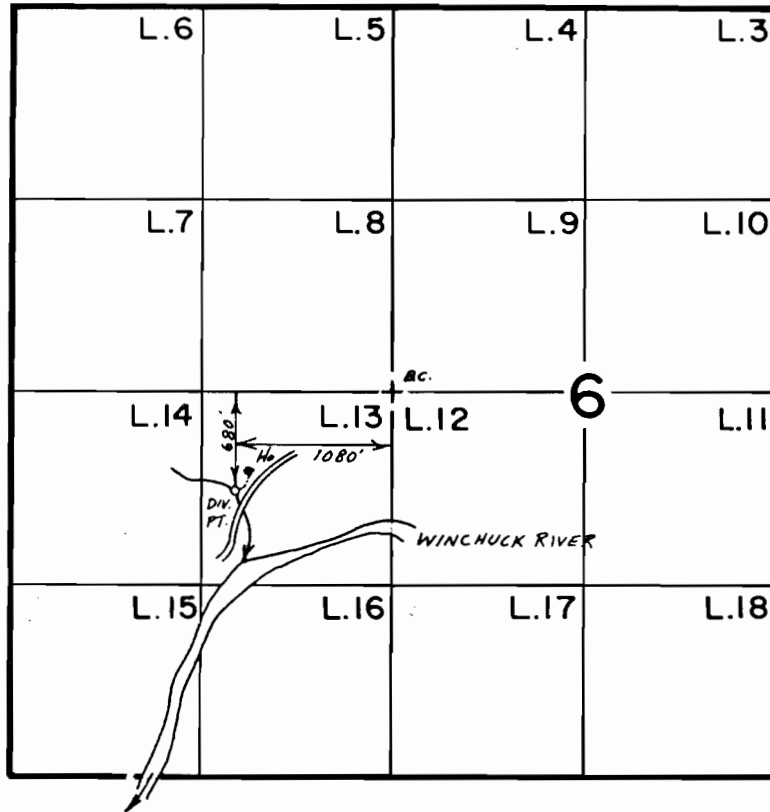

Scale 1" = 1320'

**FINAL PROOF SURVEY**  
UNDER

Application No. 57167.. Permit No. 43338.....  
IN NAME OF

ROBERT L. & NORMA J. SPEEGLE

Surveyed Oct. 8, 1988, by B.S. JAMES.....