


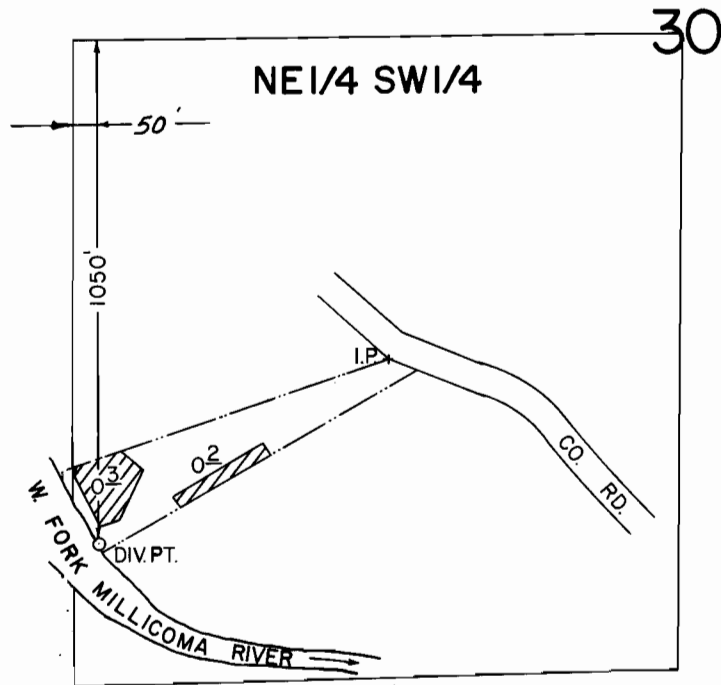

T. 24 S., R. 11 W., W.M.



SCALE: 1" = 400'

FINAL PROOF SURVEY
UNDER

Application No. 58411 Permit No. 44078.....
IN NAME OF

E. RALPH & O. JOYCE MCCOLLUM

Surveyed SEPT. 20, 1988., by B. W. BISHOP.....

Revised: 3-6-89

2-8-89

PTS