


T. 11 S. R. 6 W. W.M.

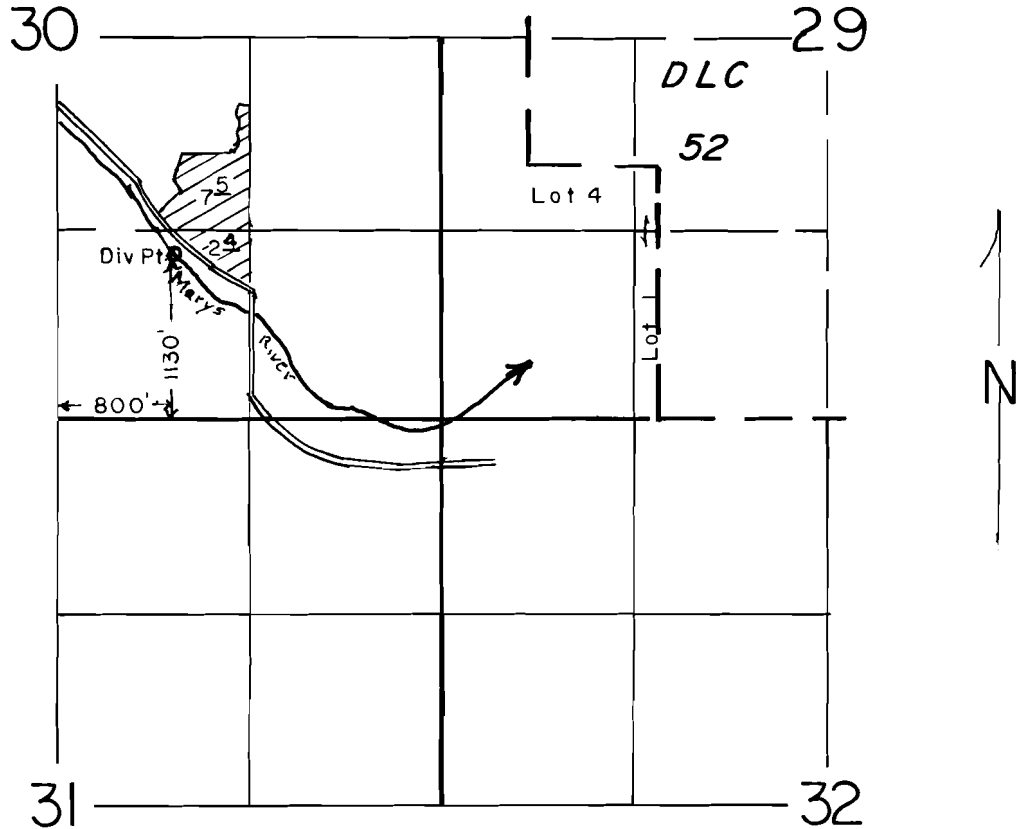

SCALE: 1" = 1320'

**FINAL PROOF SURVEY**  
UNDER

Application No. 5.8.5.52. Permit No. 4.4.1.3.8.....  
IN NAME OF

.....WILLIAM.....A.....AYRES.....

Surveyed .MAY.4.... 19.87, by T.M...WARREN....