




T.26S.,R.12&13W.,W.M.

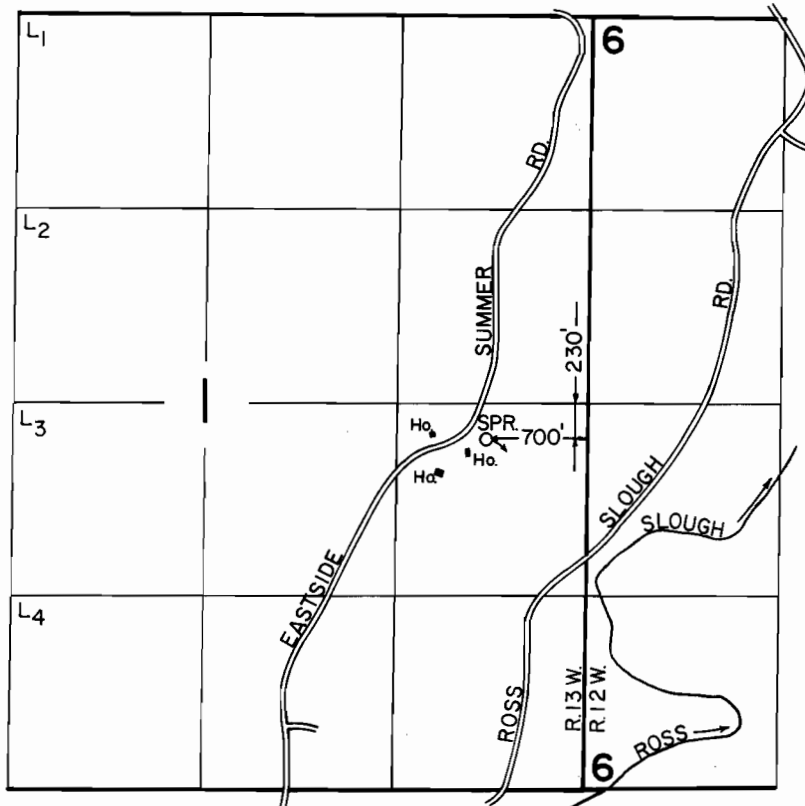

SCALE: 1" = 1320'

**FINAL PROOF SURVEY**  
UNDER

Application No. 58775. Permit No. 44708.....  
IN NAME OF

JOHN E. RIDER

Surveyed SEPT. 20 1988., by L. H. NUNN.....