




T. 27 S., R. 12 W., W.M.

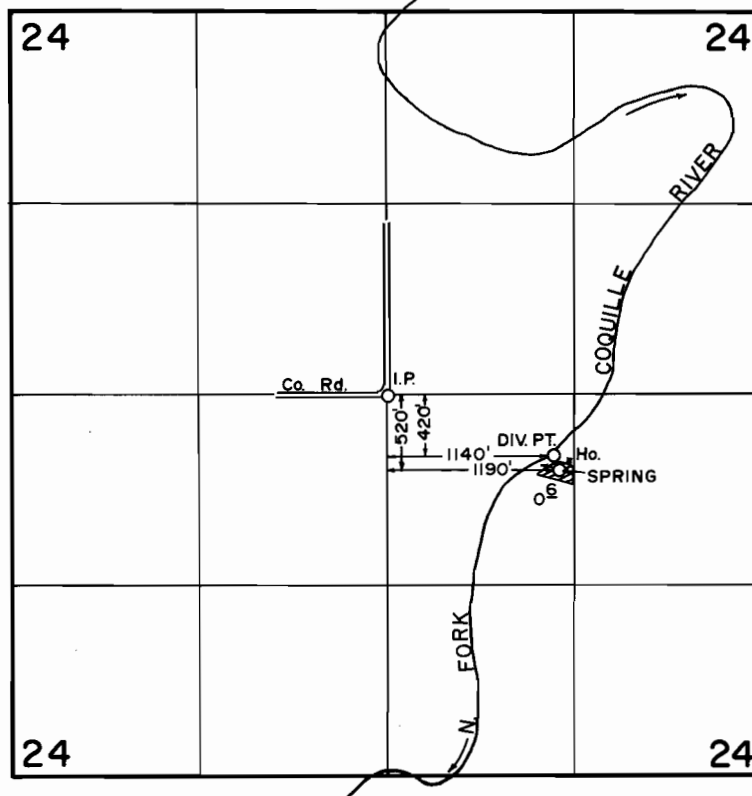

SCALE: 1" = 1320'

FINAL PROOF SURVEY
UNDER

Application No. 58793 Permit No. 44648.....
IN NAME OF

EUGENE & LAURA CHORMICLE.....

Surveyed SEPT. 20 1988, by Z. SALEH.....