




T.25 & 26S., R.14 W., W.M.

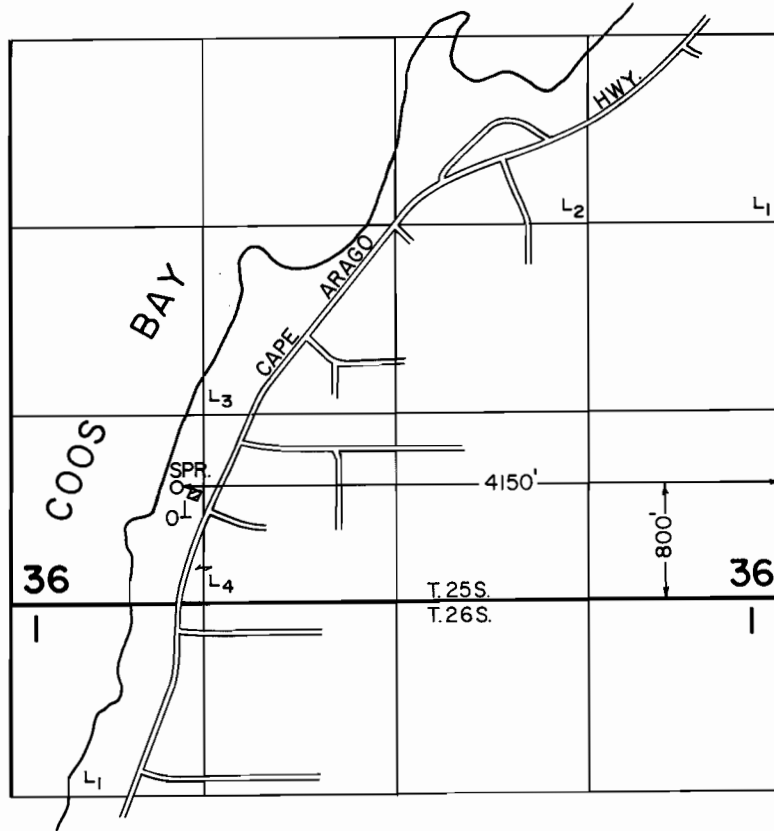

SCALE: 1" = 1320'

FINAL PROOF SURVEY
UNDER

Application No. 59351... Permit No. 44652.....
IN NAME OF

JACKSON T. MOORE

Surveyed SEPT. 17, 1988, by L. H. NUNN.....