


# T. 26 S., R. 4 W., W.M.

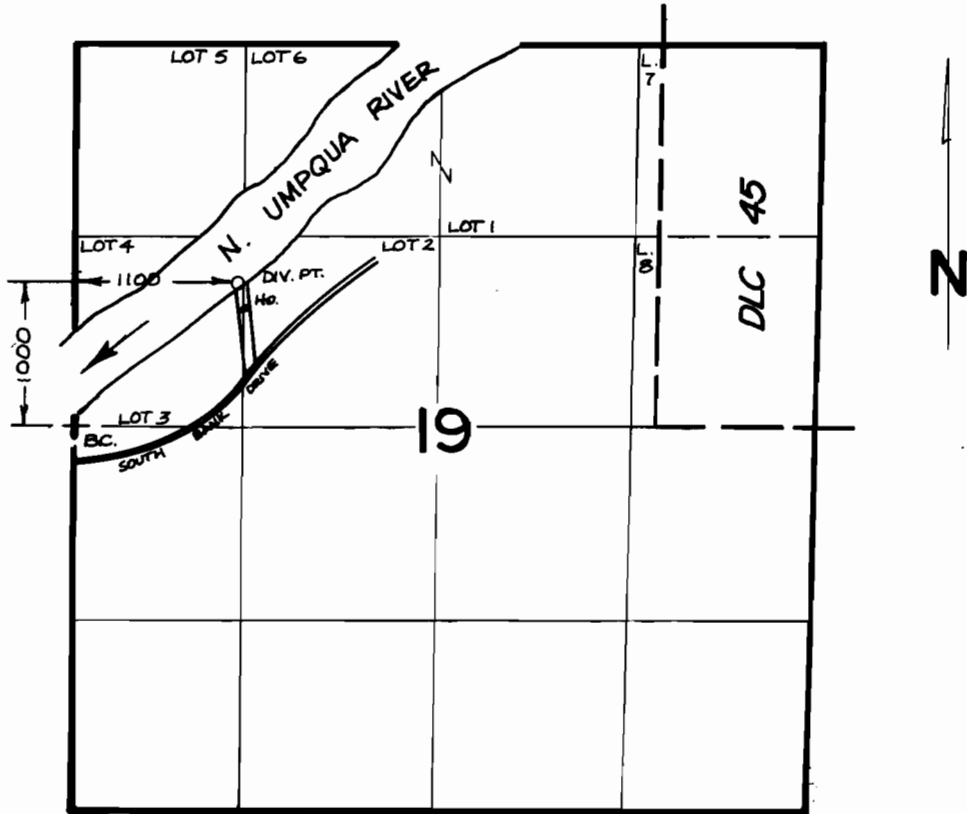

SCALE : 4" = 1 MILE

## FINAL PROOF SURVEY UNDER

Application No. ...60463 Permit No. ....45258....  
IN NAME OF

.....EDNA...H...STRADER.....

Surveyed .MAR.,.31., 19.86, by ...J.M..SCHMORDE.