


T. 41 S. , R. 12 W. , W. M.

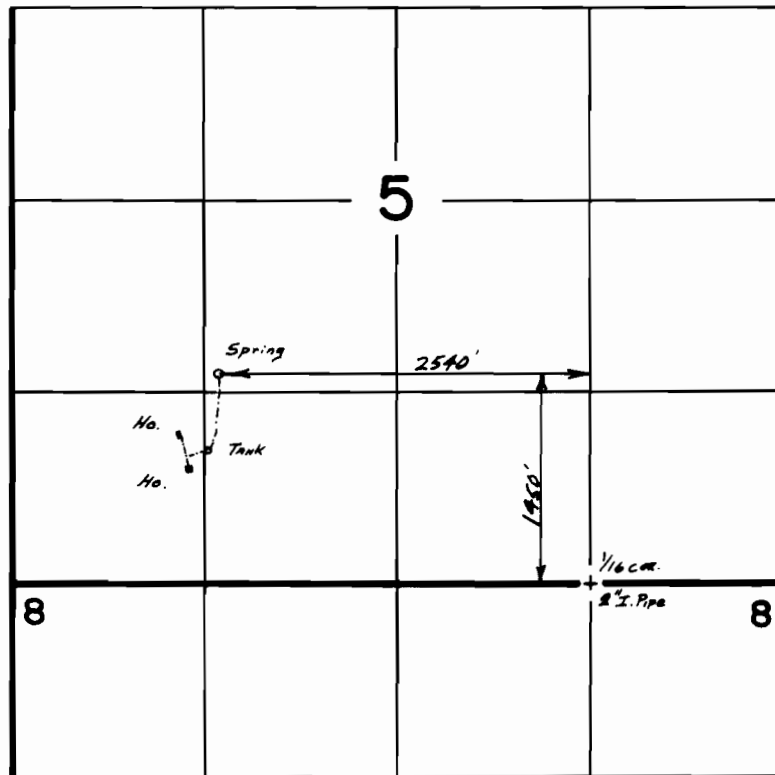

Scale 1"=1320'



**FINAL PROOF SURVEY**  
UNDER

Application No. 60569. Permit No. 45312.....  
IN NAME OF

.....LENA.....MOYNAHAN.....

Surveyed Oct. 8, 1988, by B.S. JAMES.....